


T. 28 S..R. 10 W. W.M.

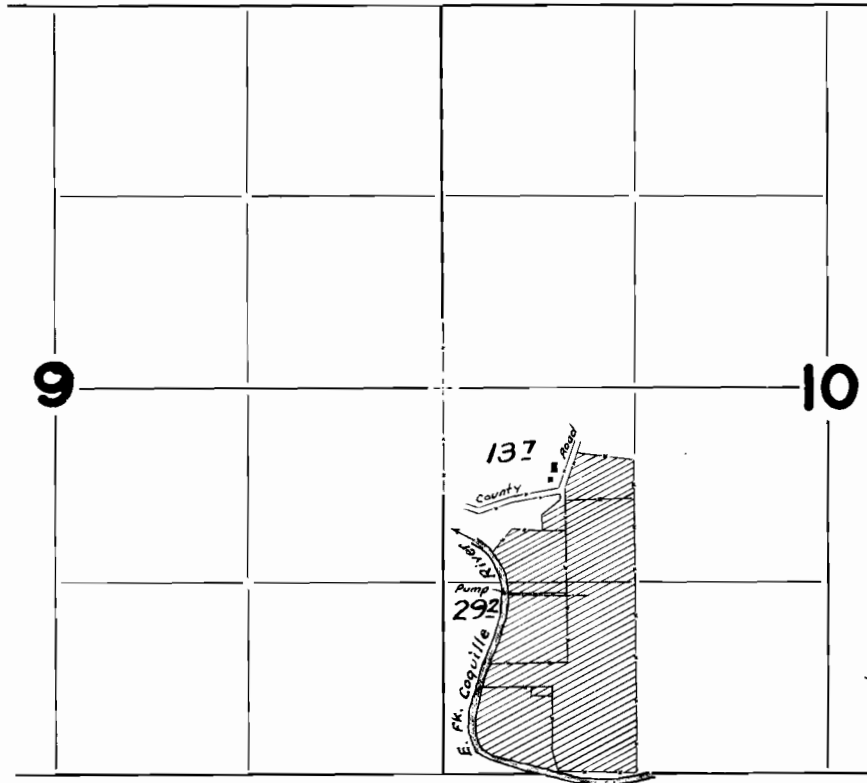

FINAL PROOF SURVEY
UNDER

Application No. 17827 Permit No. 13496

IN NAME OF

Oscar M. or Hilda A. Durrell

Surveyed Aug. 26 1943, by Geol. Daderman