


T.13 S., R. 2 E. W.M.

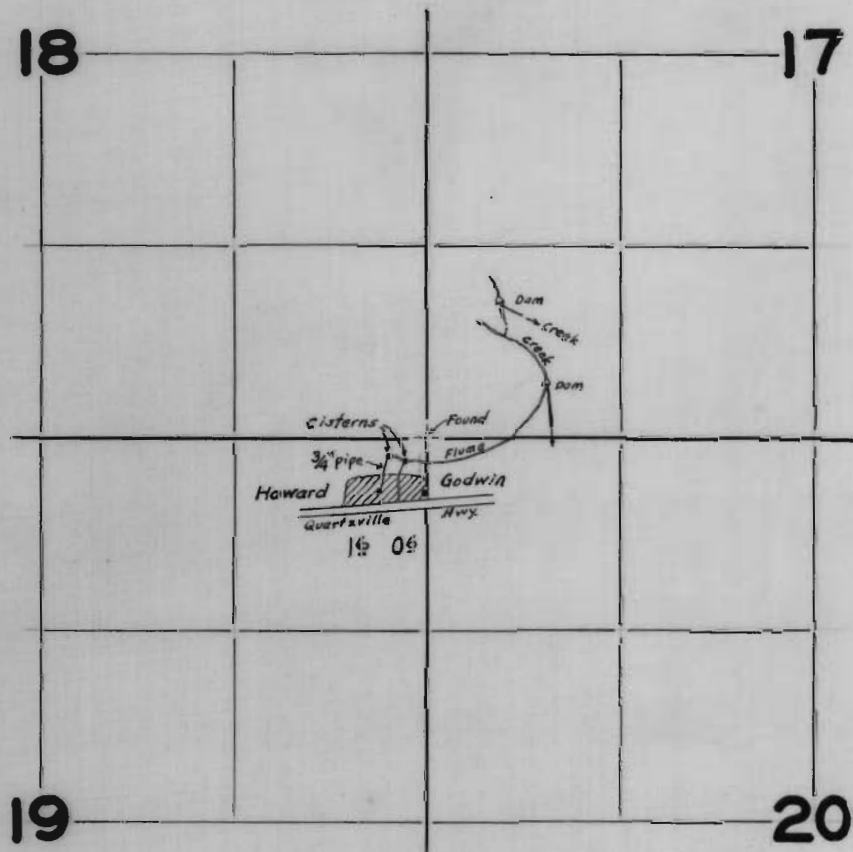

FINAL PROOF SURVEY  
UNDER

Application No. 17889 Permit No. 13513

IN NAME OF

James C. Godwin and Joseph M. Howard

Surveyed Sept. 4, 1942, by Geo. D. Paderman