


# T. 16 S.. R. 1 W. W.M.

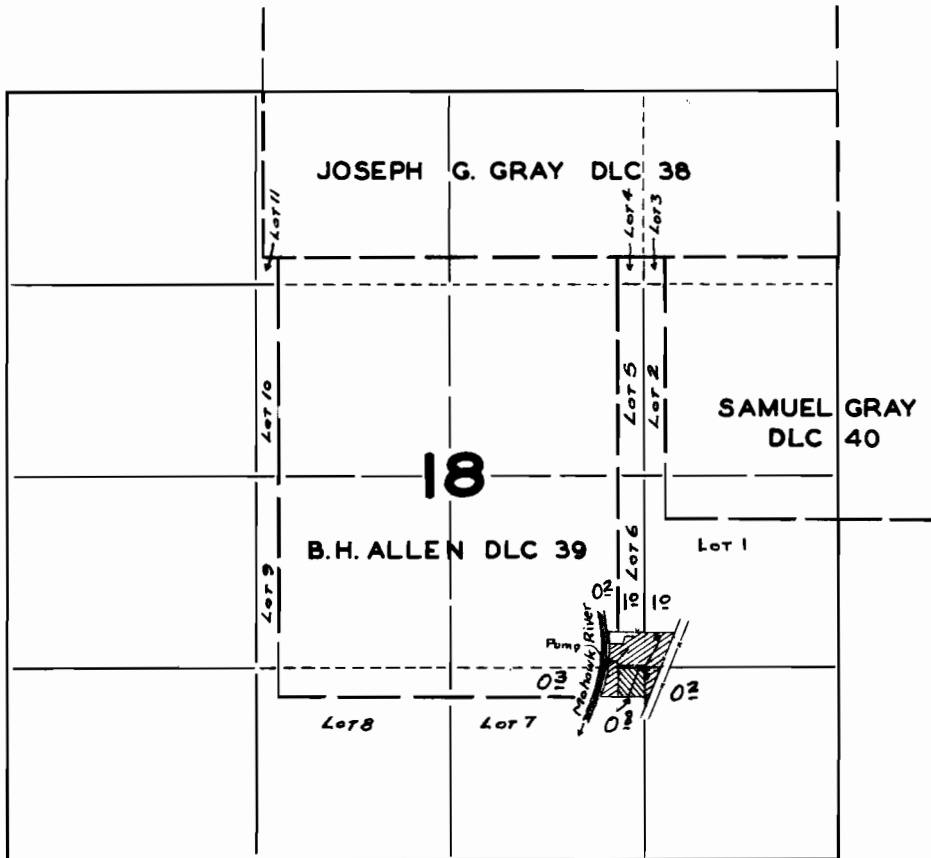

- ▨ Permit 13534
- ▨ Permit 14863

## FINAL PROOF SURVEY

UNDER

Application No. <sup>17849</sup>~~19265~~ Permit No. <sup>13534</sup>~~14863~~

IN NAME OF

*Ray A. & Marguerite M. Winegar*

Surveyed *Aug. 3* 1943, by *Geo. D. Daderman*