


T. 25 S., R. 13 W. W.M.

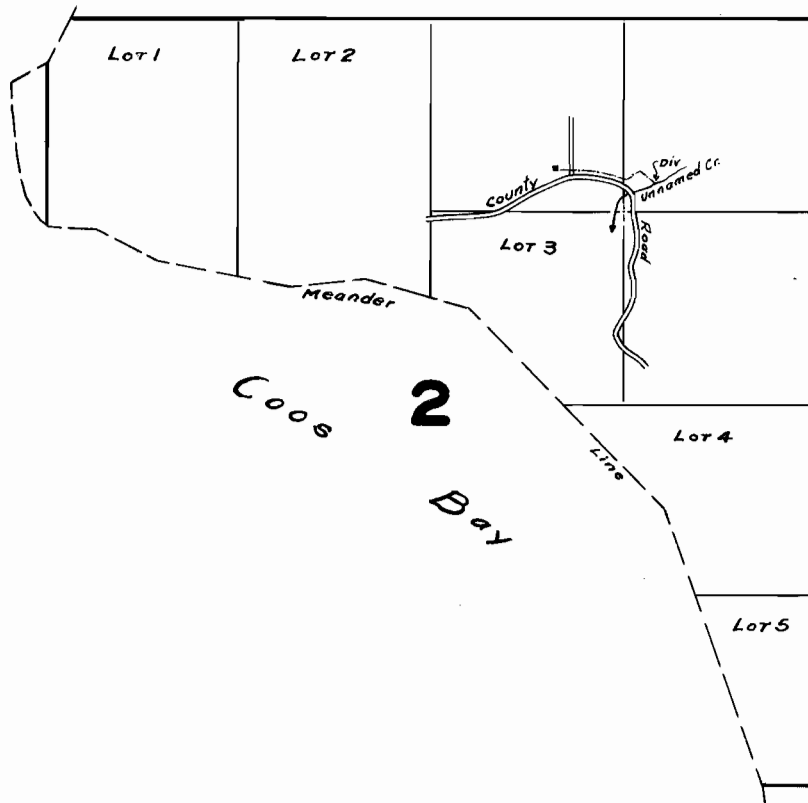

**FINAL PROOF SURVEY
UNDER**

Application No. 17859 Permit No. 13540

IN NAME OF

H. B. Fulton

Surveyed Aug. 20, 1943, by Geo. W. Pederman