


T. 31 S., R. 1 W. W.M.

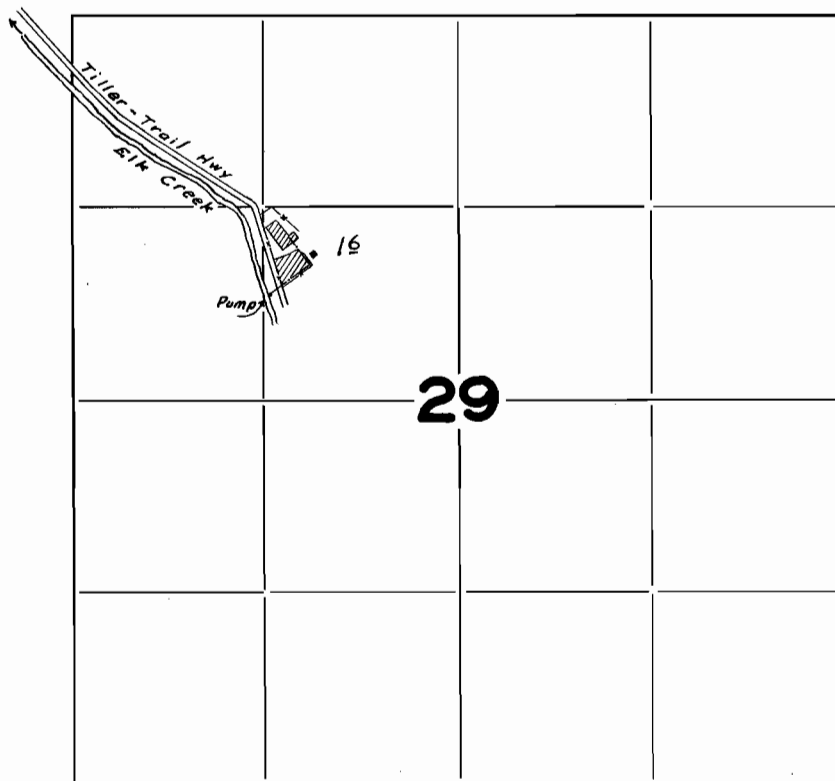

FINAL PROOF SURVEY

UNDER

Application No. 17862 Permit No. 13543

IN NAME OF

Columbus S. Jackson

Surveyed Sept 7 1943, by Geo. W. Anderson