


T. 17 S., R. 2 W. W.M.

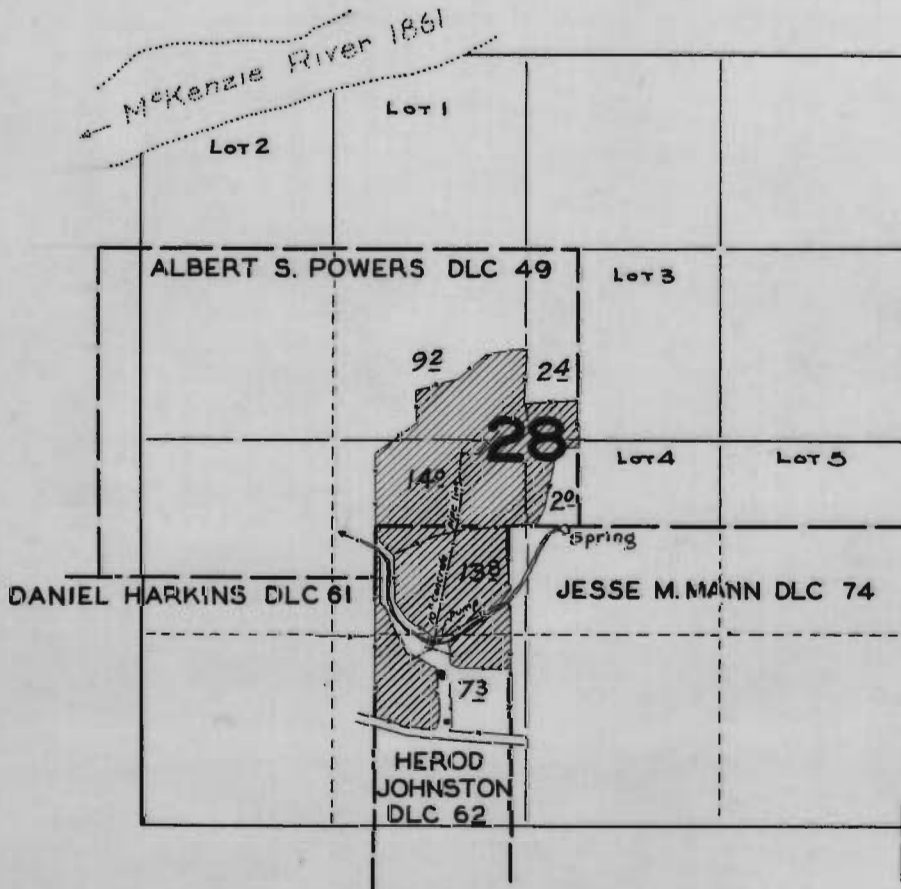

FINAL PROOF SURVEY UNDER

Application No. 17911 Permit No. 13597

IN NAME OF

Christian W. Hansen

Surveyed Aug. 3 1943, by Carl Spederman