


T. 19 S. R. 1 W. W. M.

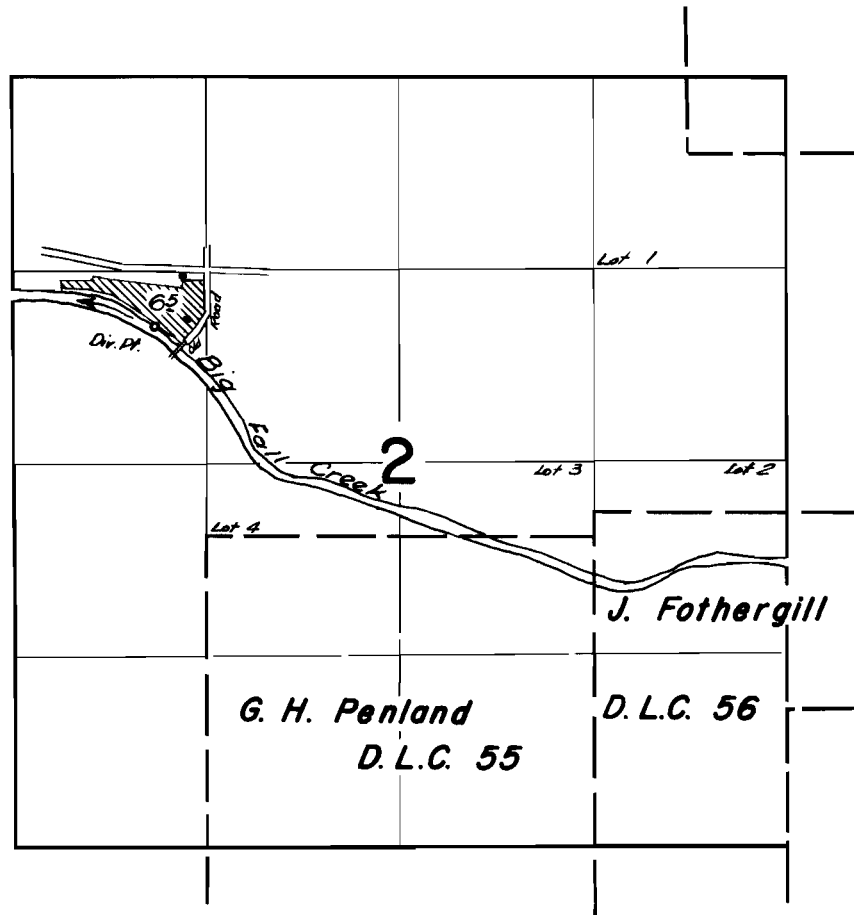

FINAL PROOF SURVEY UNDER

Application No. 17939 Permit No. 13621
IN NAME OF

L. D. LESLIE

Surveyed Aug. 5 1943, by Geo. V. Naderman