


T. 5 S., R. 1 W. W.M.

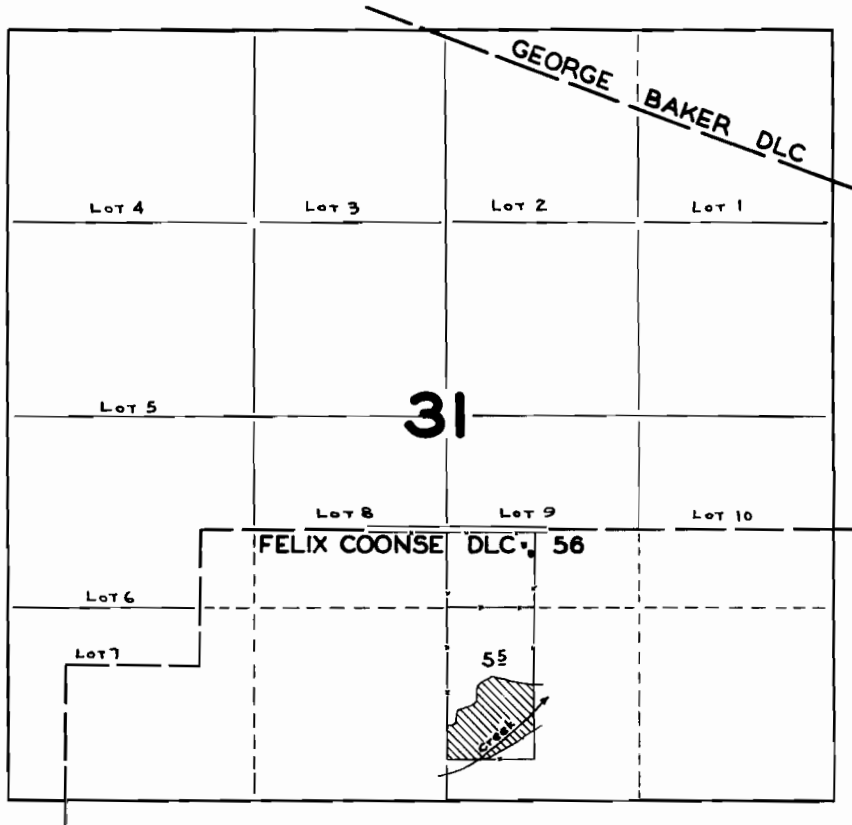

FINAL PROOF SURVEY UNDER

Application No. 17961 Permit No. 13639

IN NAME OF

Mike Engelhardt

Surveyed Sept 21 1943, by *Geo. Maderman*