


# T. 4 S., R. 2 W. W.M.

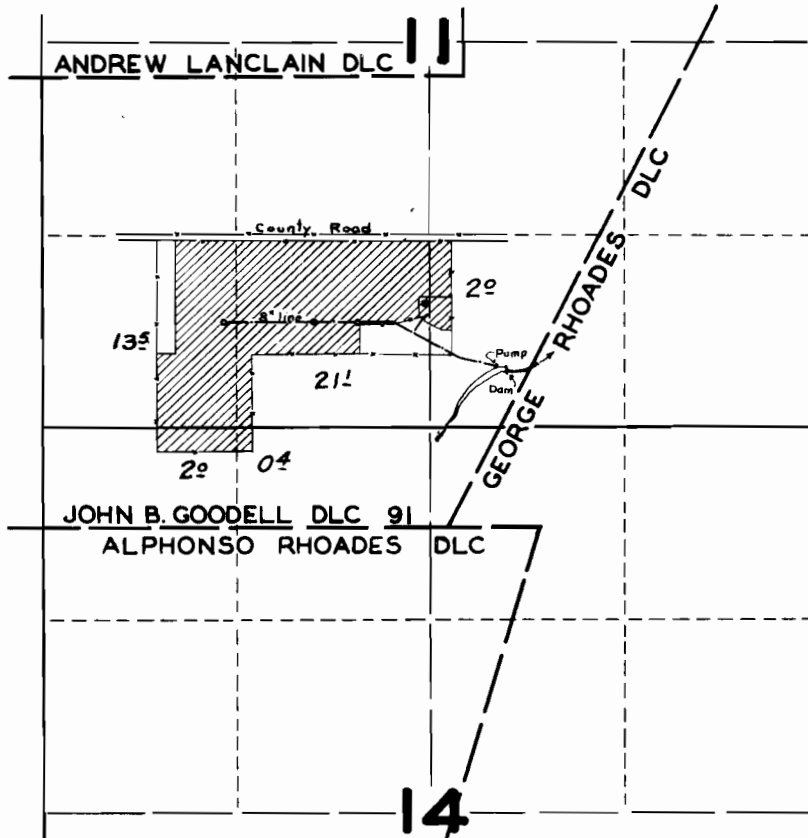

## FINAL PROOF SURVEY

UNDER

Application No. 17973 Permit No. 13684  
18677 14308

IN NAME OF

Mrs. G.M. Walker

Surveyed Sept 23 1943, by Geoff Maderman