


T. 15 S., R. 6 W. W.M.

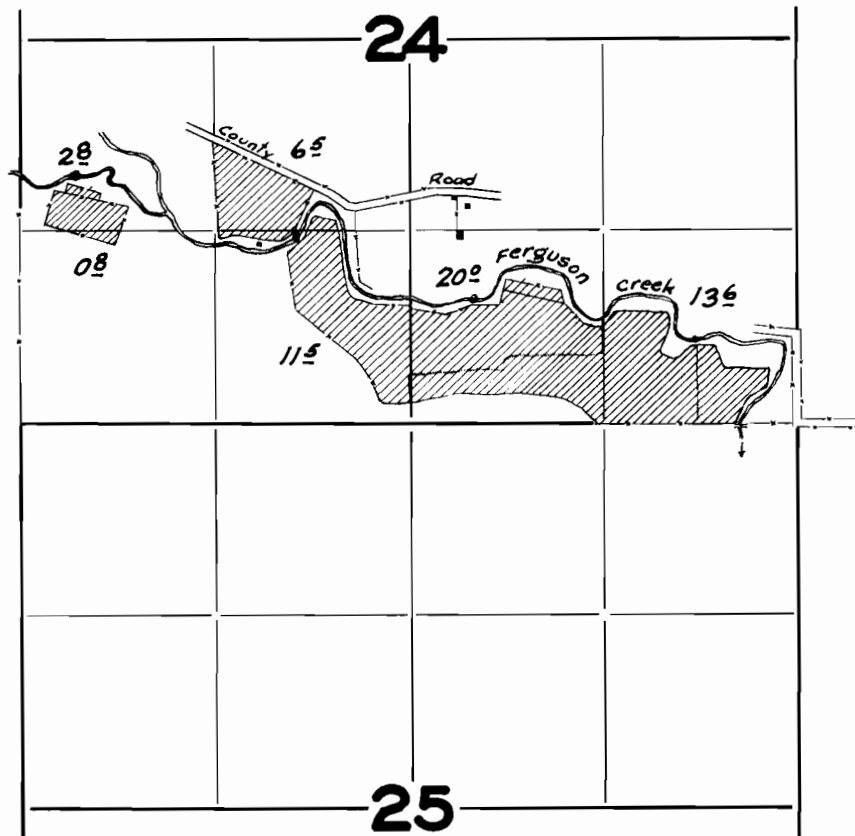

FINAL PROOF SURVEY
UNDER

Application No. 17980 Permit No. 13654

IN NAME OF

Louis Knebel

Surveyed Aug 2 19, by Geo. W. Aderman