


T. 28 S., R. 11 W. W.M.

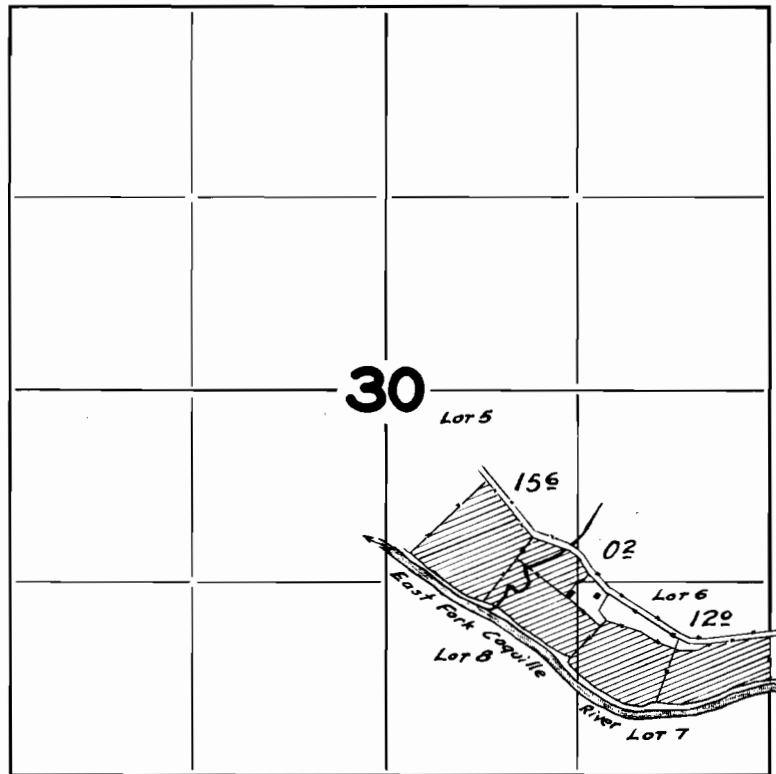

FINAL PROOF SURVEY
UNDER

Application No. 17986 Permit No. 13660

OF LAND IN

E. M. Clayton

Surveyed Aug. 26, 1943, by *Geol. T. Naderman*