


T. 9 S., R. 2 W. W.M.

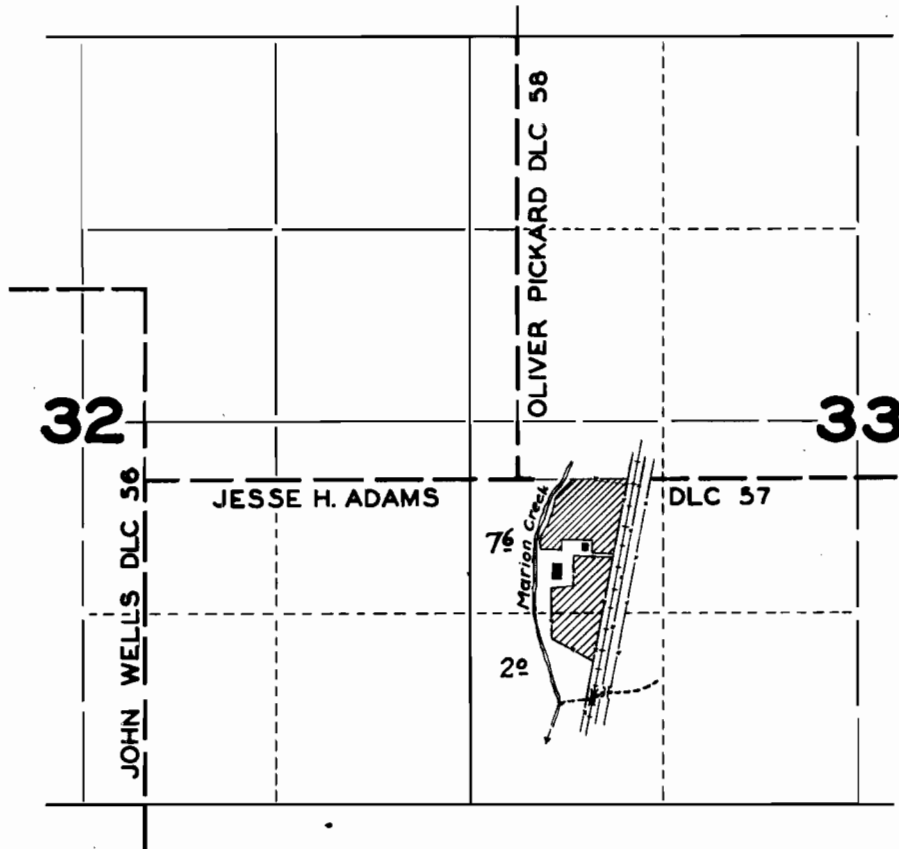

FINAL PROOF SURVEY
UNDER

Application No. 18041 Permit No. 13710

IN NAME OF

Norris E. Wells

Surveyed July 27 1943, by Geol. Pademan