


T. 29 S.. R. 12 W. W.M. .

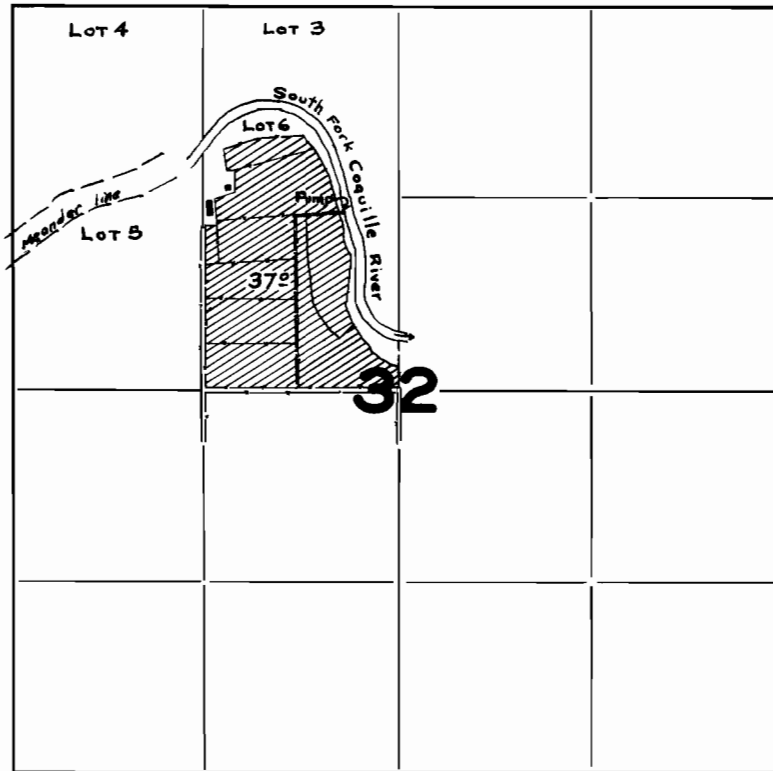

FINAL PROOF SURVEY

UNDER

Application No. 18043 Permit No. 13712

IN NAME OF

R. W. Mattson

Surveyed Aug. 27 1943, by Bert Nederman