


T. 4 S., R. 3 W. W.M.

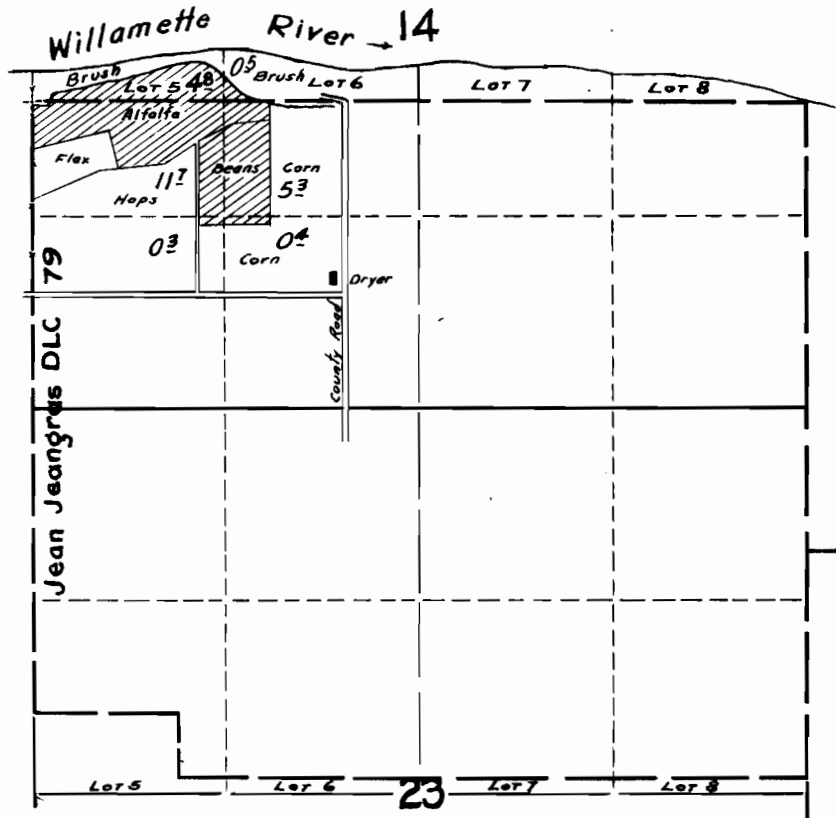

FINAL PROOF SURVEY UNDER

Application No. 18051 Permit No. 13719

IN NAME OF

Lawrence H. Bunning

Surveyed Sept. 23 1943, by Scott J. Pademan