


T. 24 S., R. 12 W. W.M.

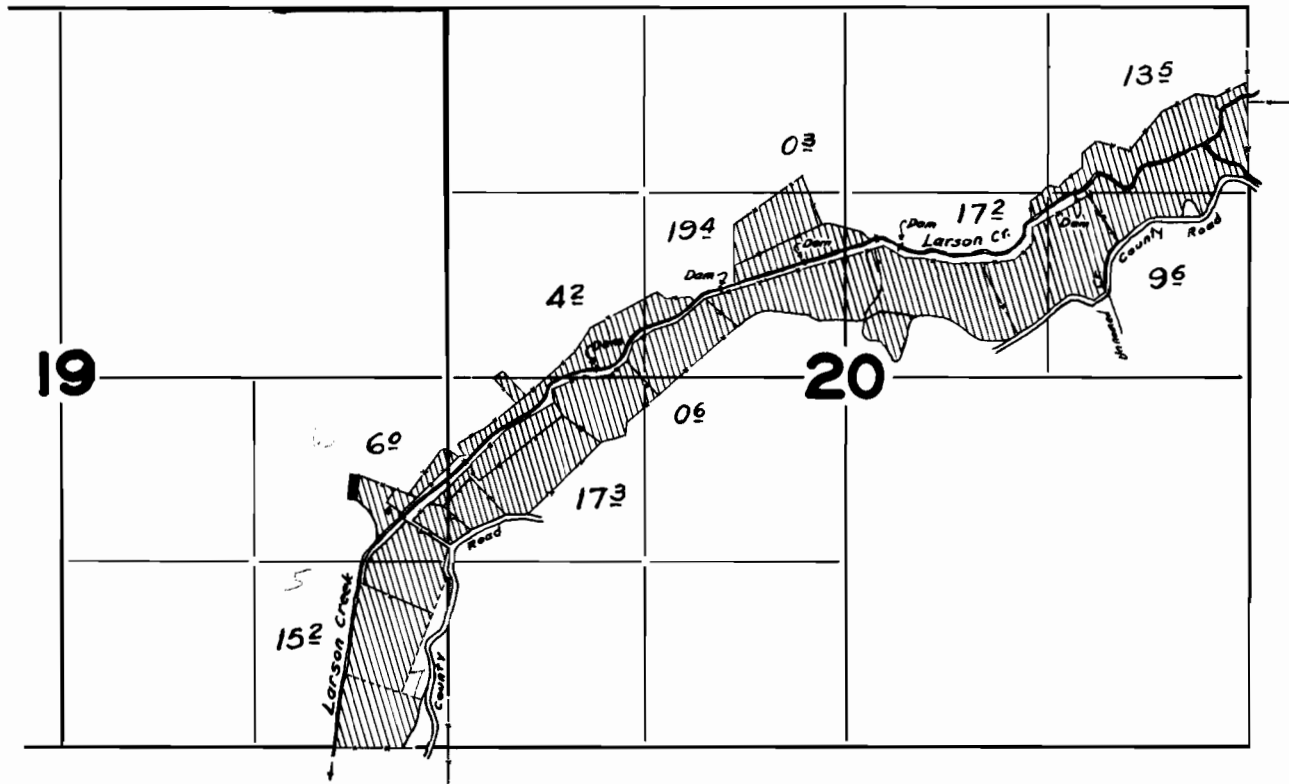

**FINAL PROOF SURVEY
UNDER**

Application No. 18094 Permit No. 13754

IN NAME OF

Herman Brelage

Surveyed Aug. 16 1943, by Earl Pedersen