


T. 16 S., R. 7 W. W.M.

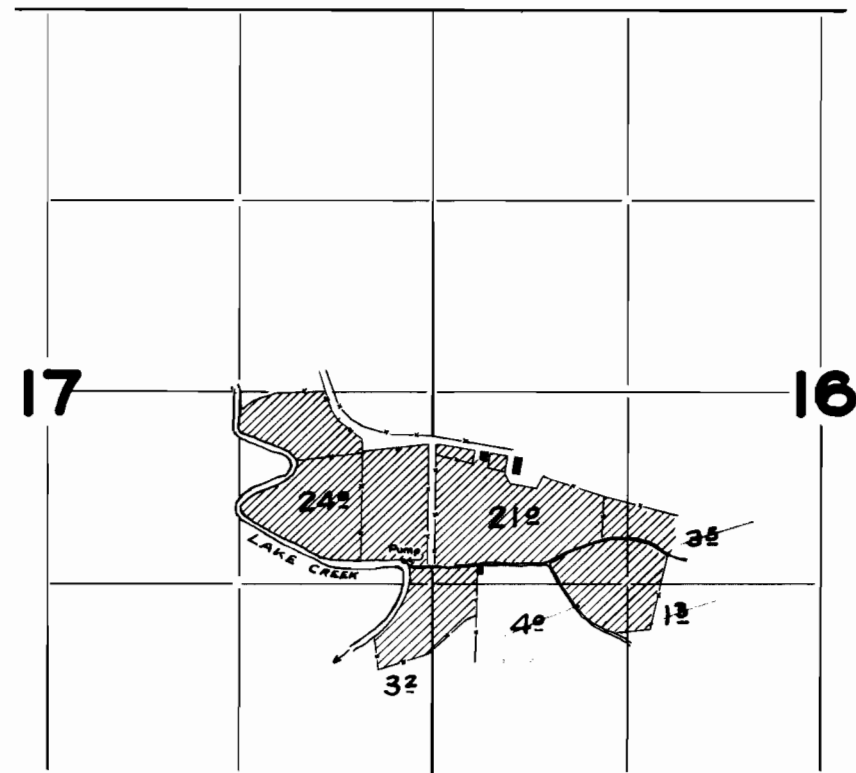

FINAL PROOF SURVEY
UNDER

Application No. 18096 Permit No. 13756

IN NAME OF

Ante Sumich

Surveyed Aug. 6, 1943, by Geo. W. Madenau