


T.16 S., R. 5 E. W.M.

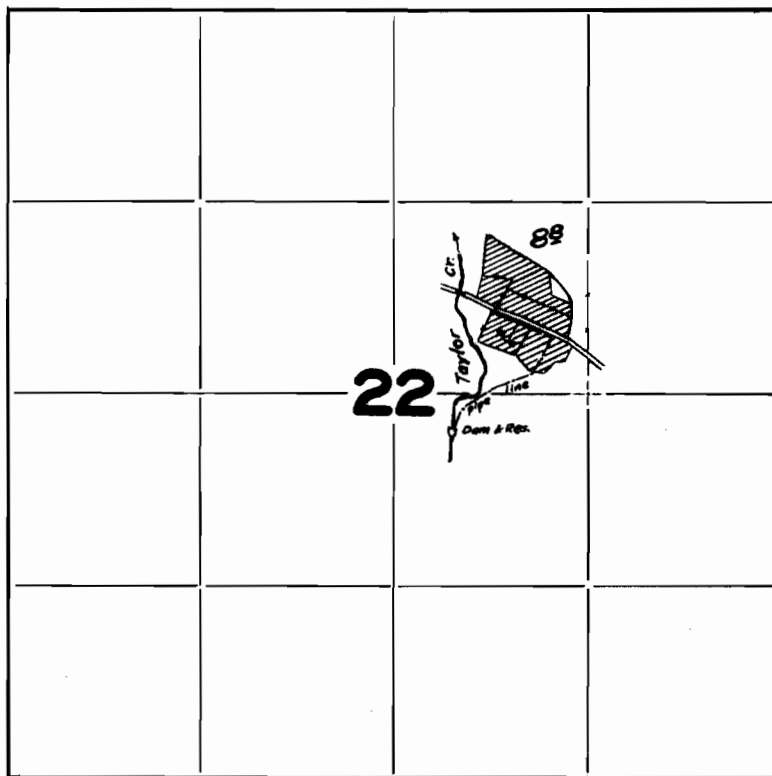

**FINAL PROOF SURVEY
UNDER**

Application No. 18090 Permit No. 13846
IN NAME OF

Hasmer E. & Hazel A. Johnson

Surveyed Aug. 7, 1943, by Geo. W. Madarman