


T. 3 S., R. 3 W. W.M.

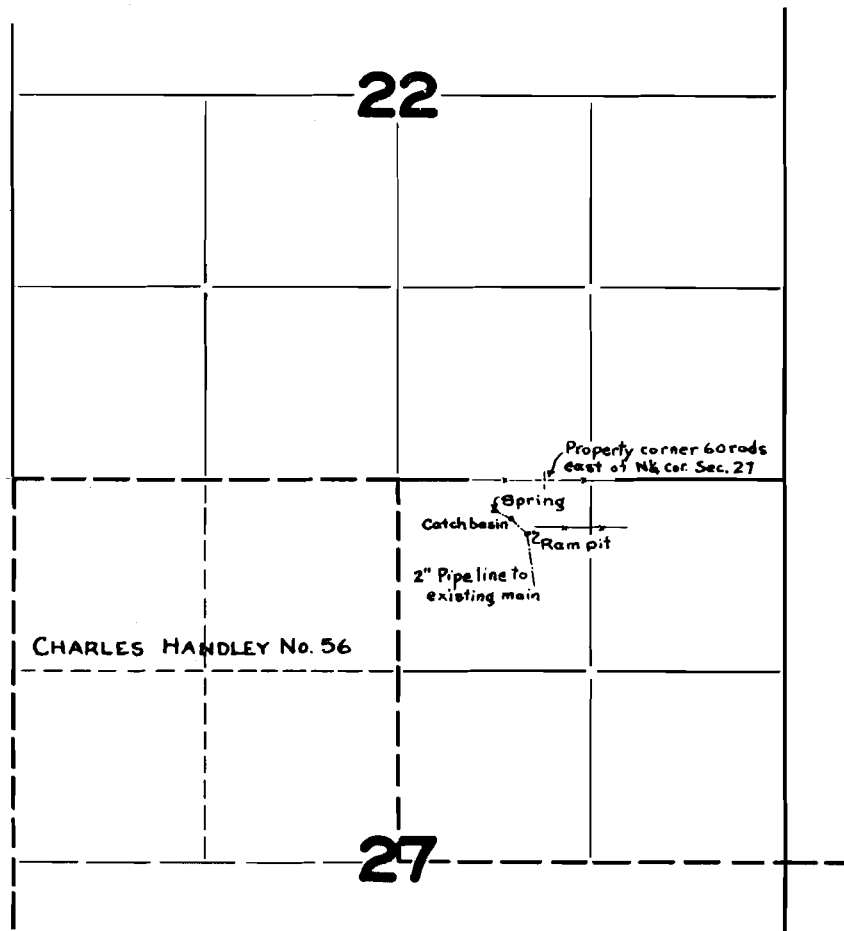

FINAL PROOF SURVEY
UNDER

Application No. 18173 Permit No. 13880

IN NAME OF

Town of Dundee

Surveyed Aug. 14, 1942, by Geoff. Naderman