


T. 28 S., R. 12 W. W.M.

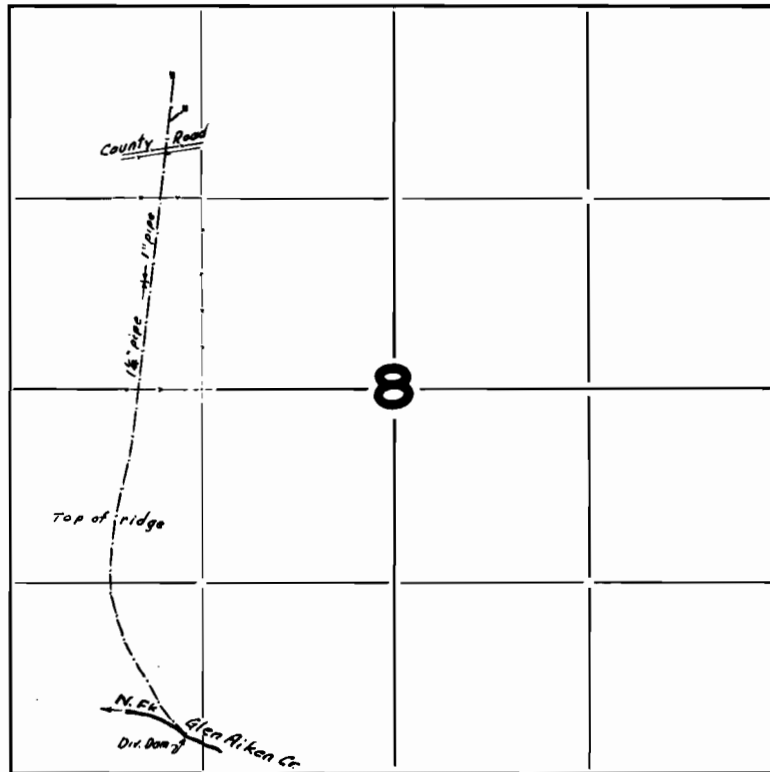

FINAL PROOF SURVEY

UNDER

Application No. 18257 Permit No. 13913

IN NAME OF

Henry L. George

Surveyed Aug. 25 1943, by Carl Maderman