


fact at 13922

T.1S. R.39E. W.M.


NWNE 7 acres - 5+
SWNE 15.1 acres - 20.1+
NENE 16.1 acres - 2.1+
27 average

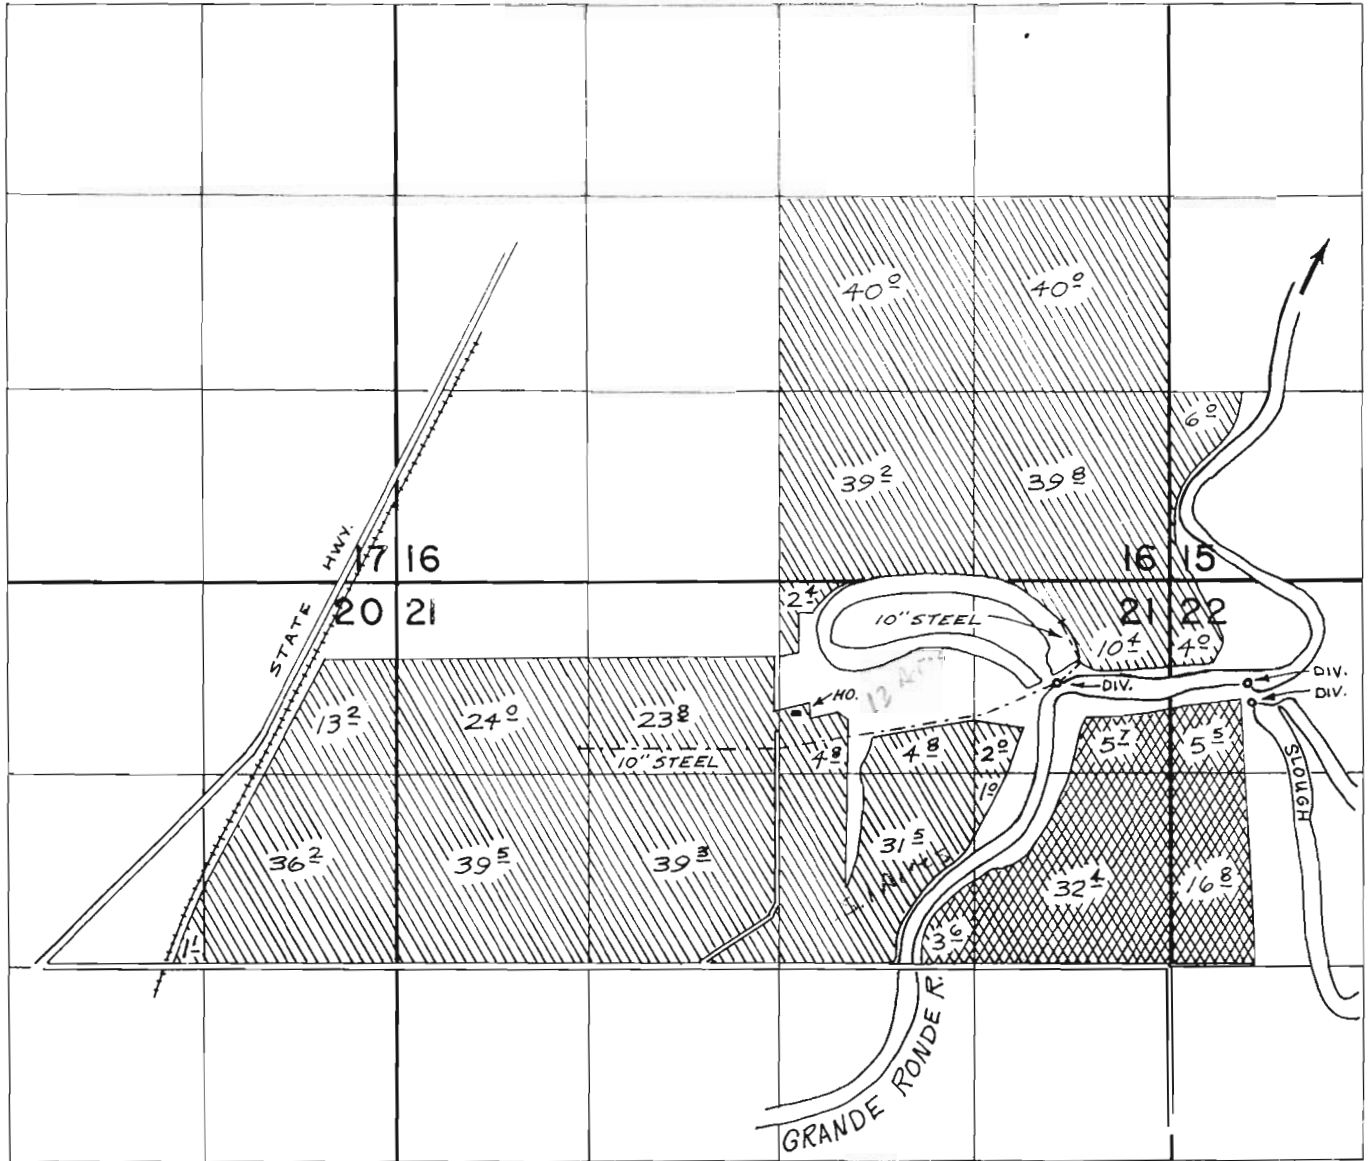

DIV. PTS. 2000'S., 775'W; 2000'S., 525'E; BOTH FROM NE. COR. SE 1/4 SE 1/4 SEC. 16
DIV. PT. 2150'S., 550'E FROM NE. COR. SE 1/4 SE 1/4 SEC. 16

FINAL PROOF SURVEY UNDER

Application No. 42062 Permit No. 31483
Application No. 37462 Permit No. 27890
IN NAME OF

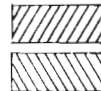

DICK HIBBERD

Surveyed July 14, 1973, by R. MUCKEN