


T. 18 AND 19 S., R. 1 E. W.M.

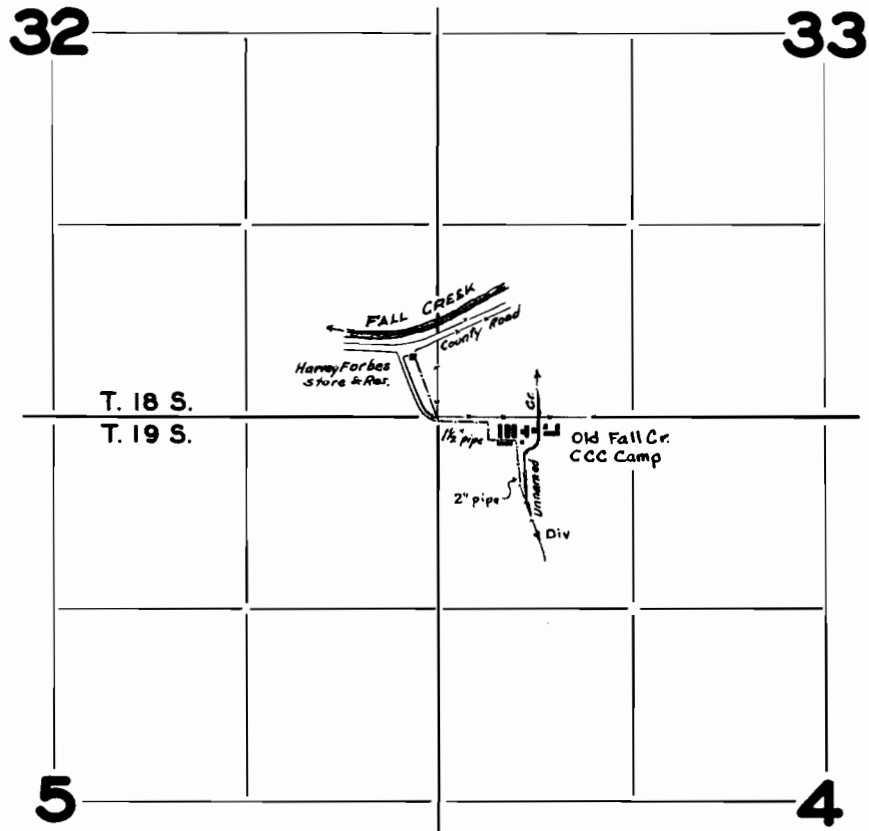

FINAL PROOF SURVEY

UNDER

Application No. 18287 Permit No. 13935

IN NAME OF

Lane County 4-H Club
Leaders Association

Surveyed Aug. 5 1943, by Geo. D. Adelman