


The legal description for
this property shows it 132' west
of the mapped location.
See also file 58608

NOTE

T. 20 S., R. 3 W. W.M.

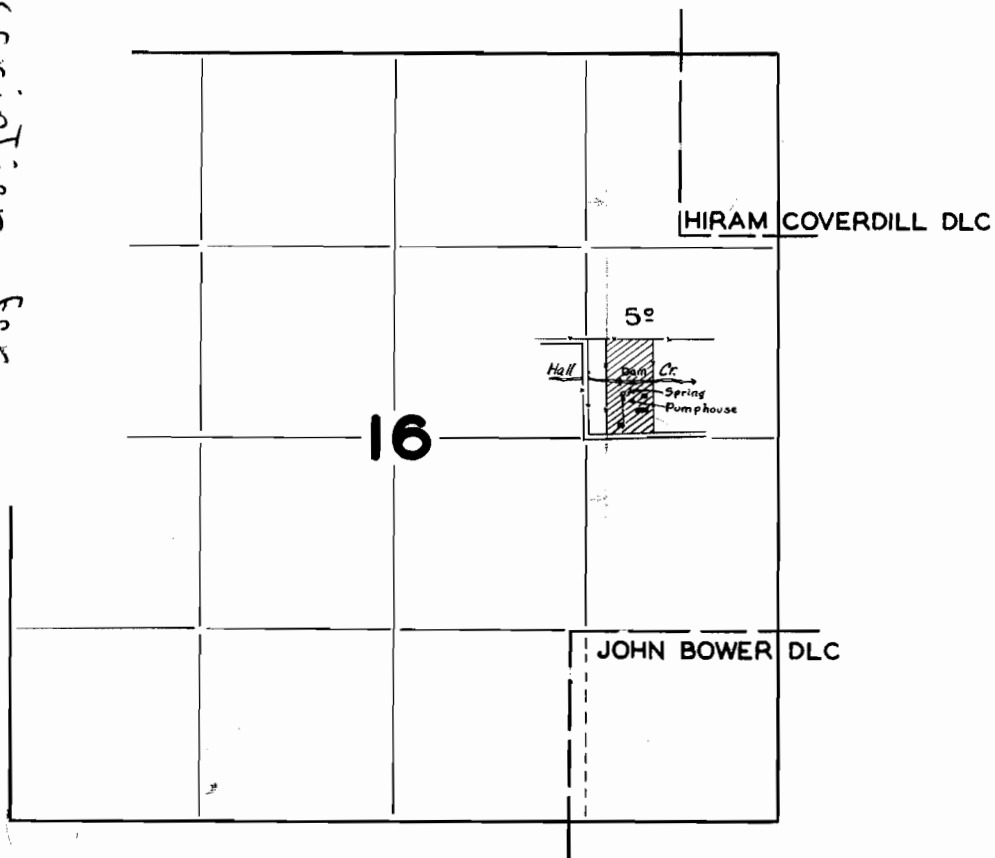

FINAL PROOF SURVEY
UNDER


Application No. 18292 Permit No. 13939

IN NAME OF

R.W. & Helen Hill

Surveyed Sept 16 1943, by Geol. Naderman

T. 20 S., R. 3 W., WM.

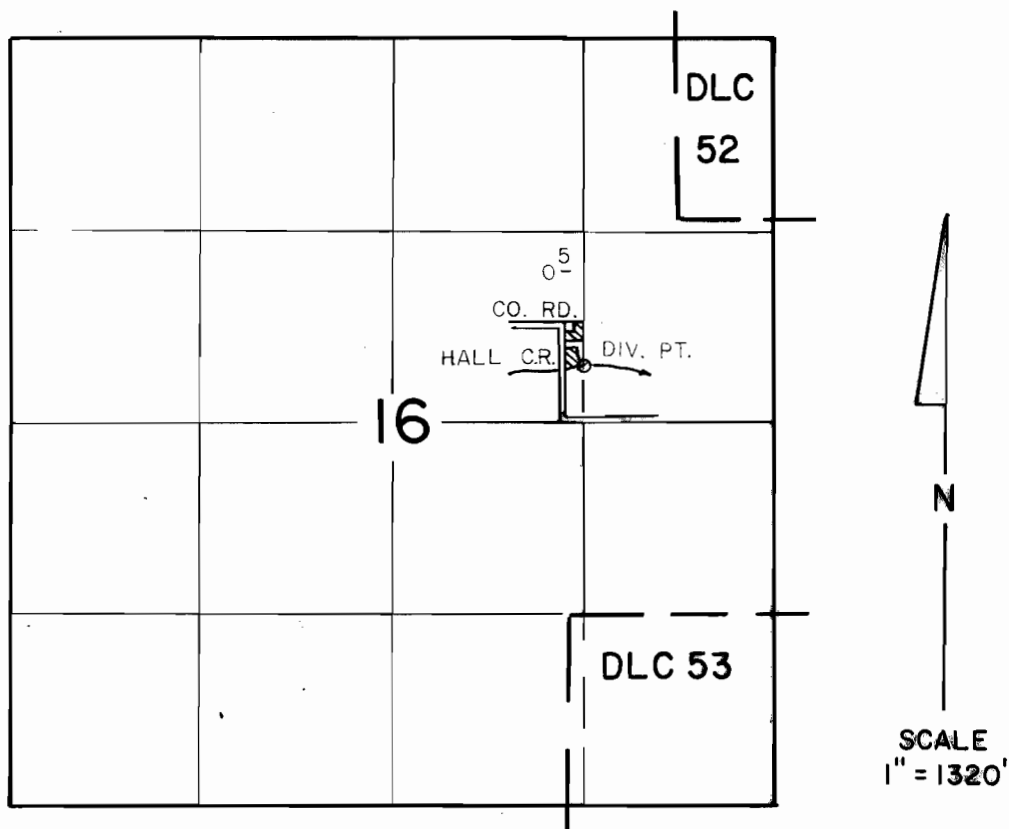

DIV. PT. LOC. 2250' S & 1320' W OF NE COR. SEC 16

FINAL PROOF SURVEY UNDER

Application No. 58608... Permit No. 44191.....
IN NAME OF

GARTH R. DEGARLAIS & EARL L. COOPER

Surveyed AUG 29 1984, by P. PAGTER.....