


T. 30 S., R. 12 W. W.M.

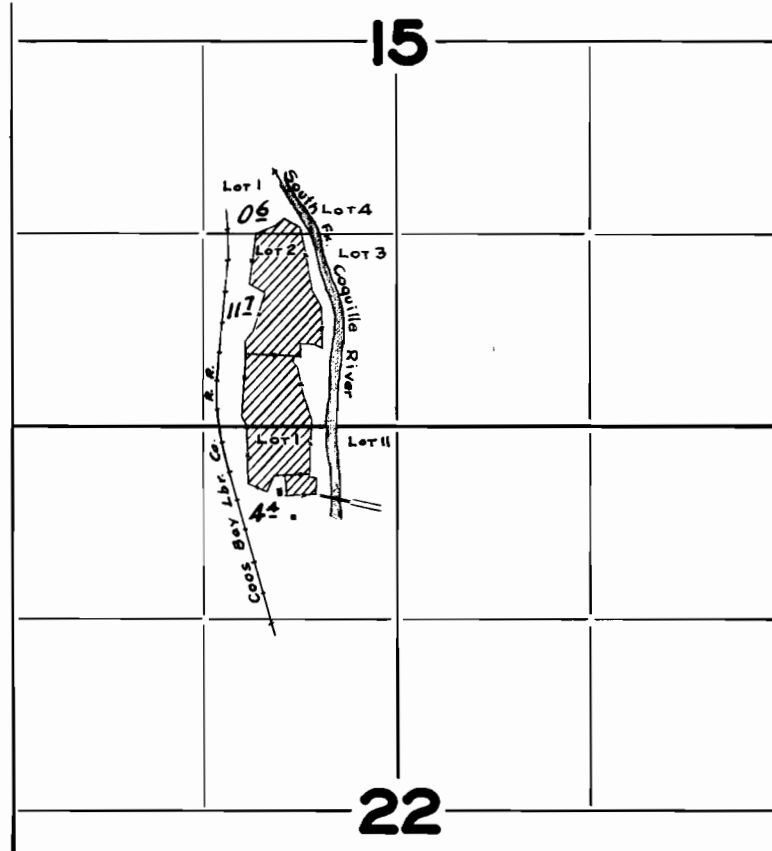

**FINAL PROOF SURVEY**  
UNDER

Application No. 18333 Permit No. 13966

IN NAME OF

George L. Boren

Surveyed Aug. 27 1943, by Scott Jaderman