


T. 28 S., R. 13 W. W.M.

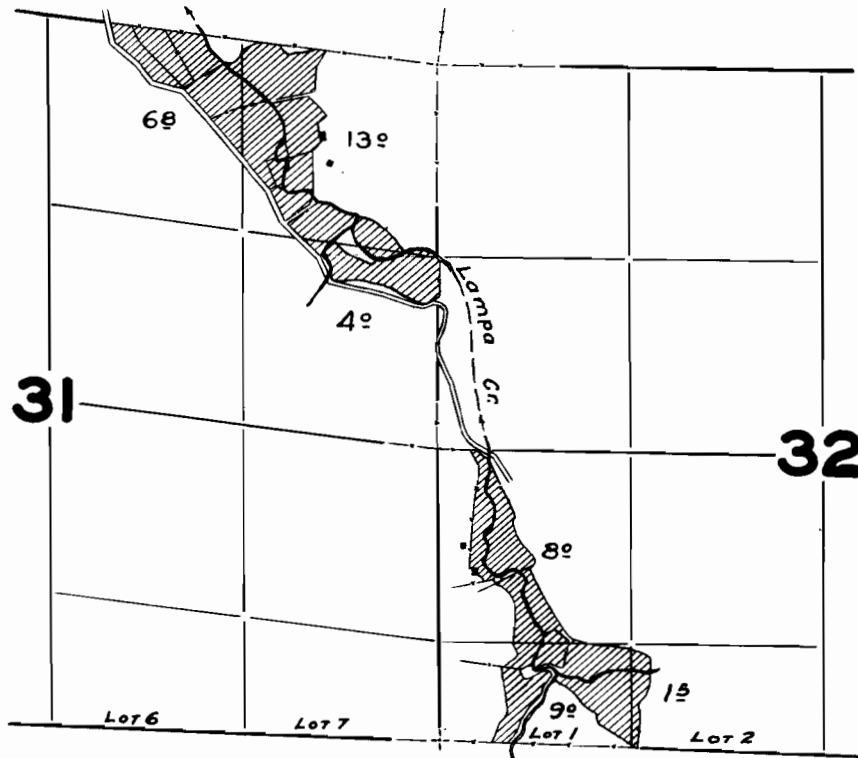

**FINAL PROOF SURVEY
UNDER**

Application No. 18358 Permit No. 13982

IN NAME OF

M. J. Monson

Surveyed Aug. 30 1943, by Scott Pederman