


T. 27 S., R. 13 W. W.M.

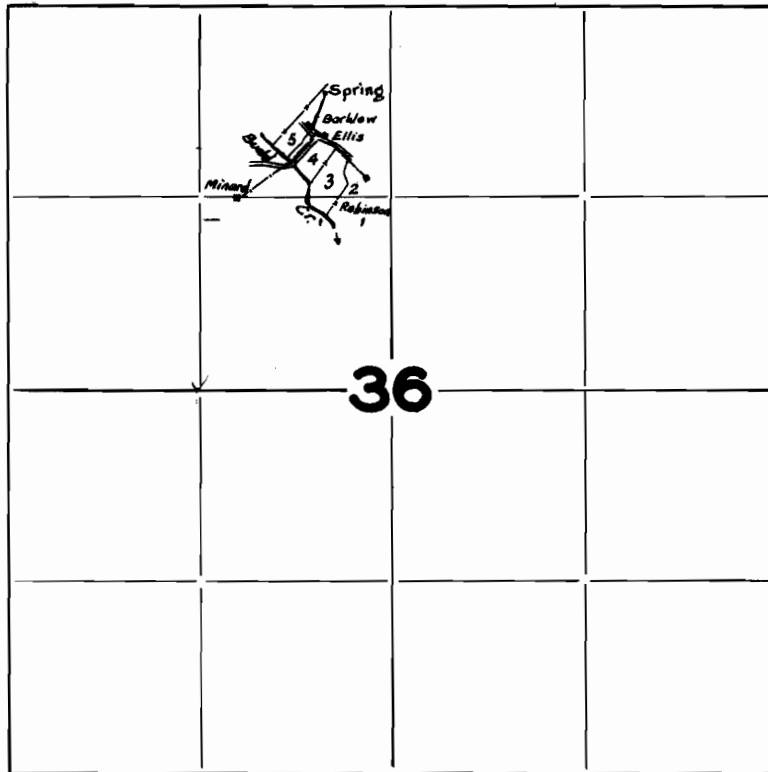

Tract 1 & 2 Frank Robinson
" 3 Clyde Minard
" 4 Ray L. Ellis
" 5 Arlyn Barklew

FINAL PROOF SURVEY
UNDER

Application No. 18363 Permit No. 13986

IN NAME OF

Irwin Watson

Surveyed Aug 24 1943, by Geo. A. Anderson