


T. 28 S., R. 12 W.W.M.

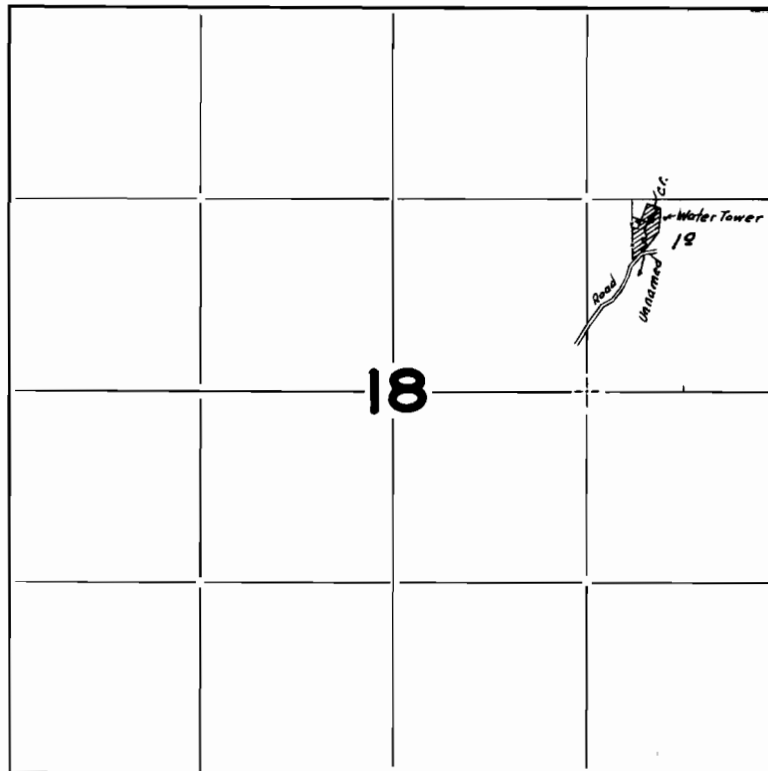

FINAL PROOF SURVEY
UNDER

Application No. 18185 Permit No. 13996

IN NAME OF

O. H. & Delta Fabian Miller

Surveyed Aug. 24 1943, by Geor. Madarman