


T. 6 S., R. 1 W. W.M.

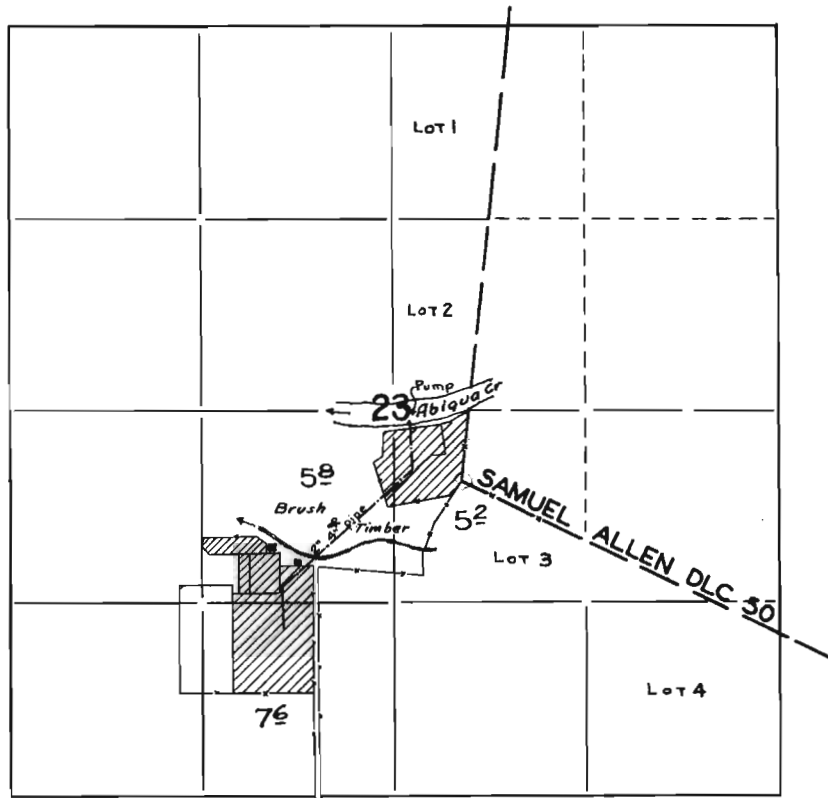

FINAL PROOF SURVEY UNDER

Application No. 18378 Permit No. 14020

IN NAME OF

Elser Aarhus

Surveyed Sept 21 1943, by Leol Naderman