


T. 3 S., R. 1 W. W.M.

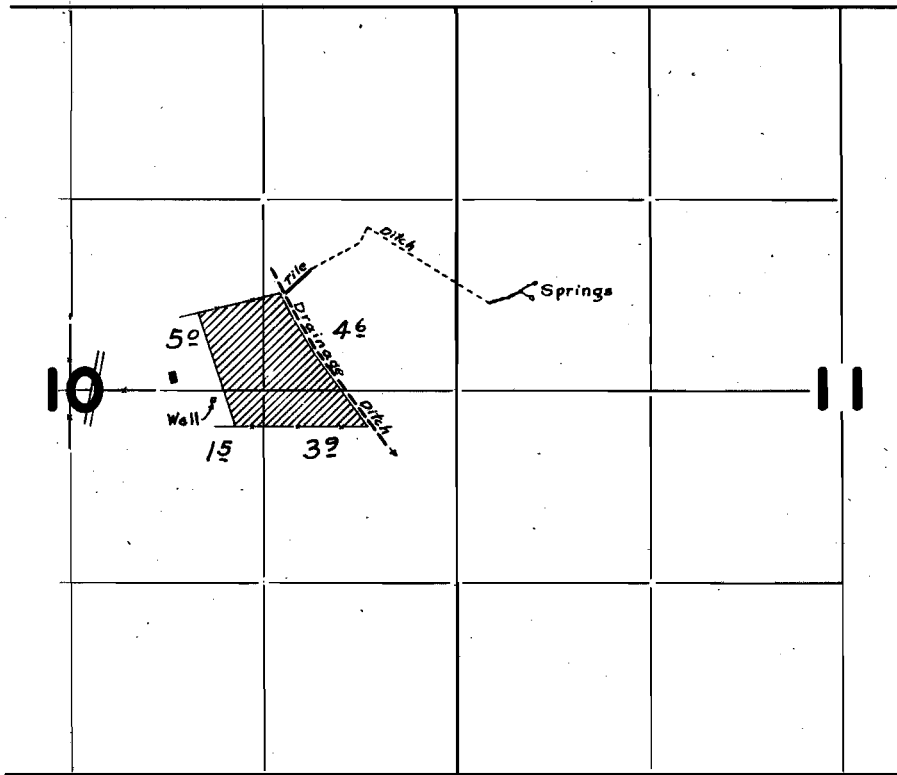

FINAL PROOF SURVEY

UNDER

Application No. 16337 ~~18387~~ Permit No. 12138 ~~14028~~

IN NAME OF

John H. & Mary L. Junor

Surveyed July 31, 1942, by Geor. Madernan