


T. 2 S., R. 1 W. W.M.

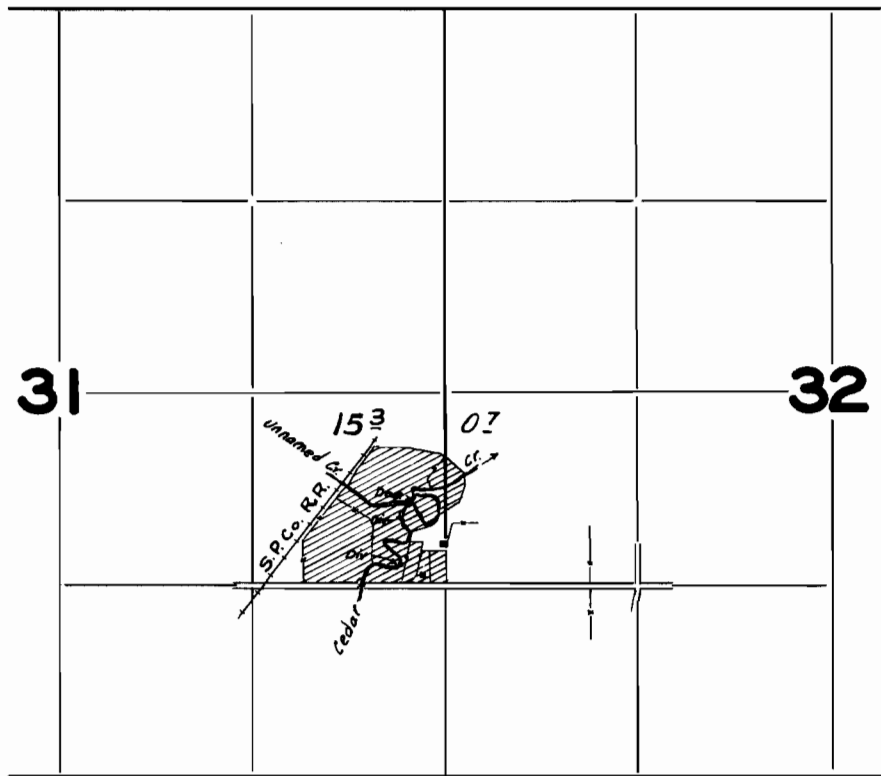

**FINAL PROOF SURVEY**  
UNDER

Application No. 18392 Permit No. 14032

IN NAME OF

Charles E. Tykeson

Surveyed Aug. 3 1942, by Gert J. Naderman