


# T. 36 S., R. 14 W. W.M.

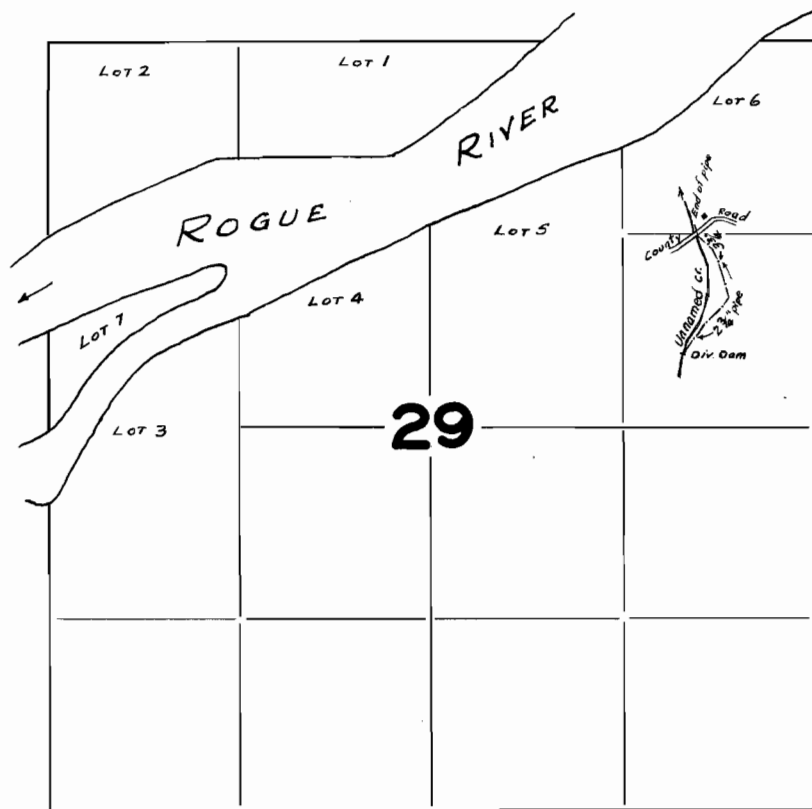

UNDER

Plan No. 18495 Permit No. 14116

IN FAVOR OF

*W.M. Flood*

Sept 2 1943, by *Geo. Maderman*