


T. 25 S., R. 13 W. W.M.

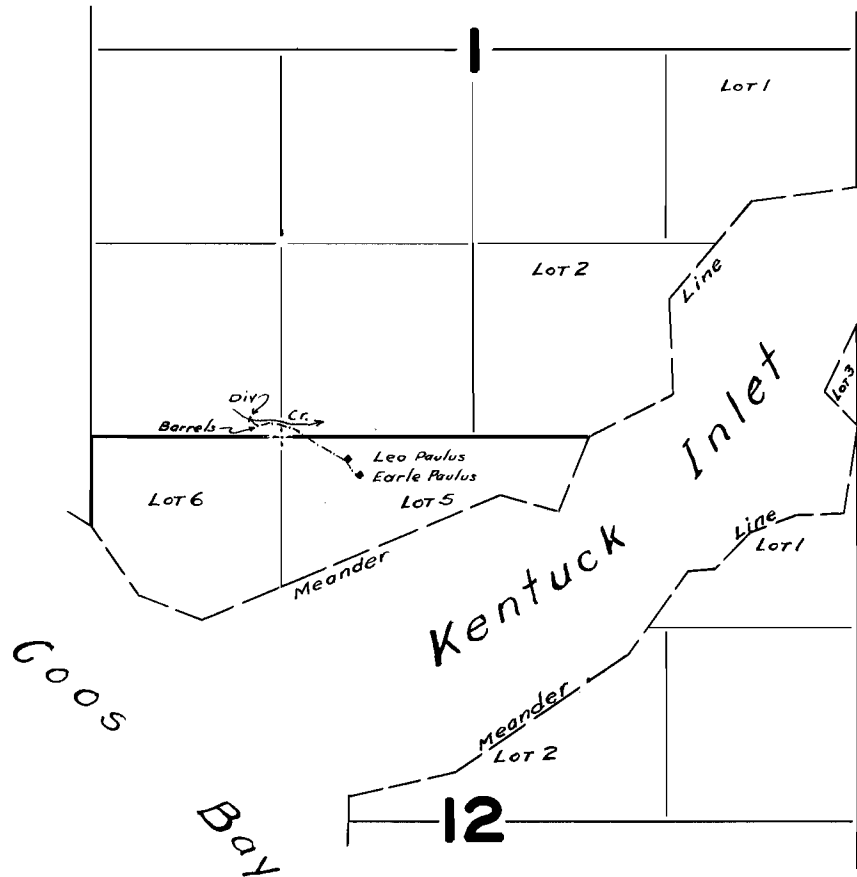

FINAL PROOF SURVEY
UNDER

Application No. 18499 Permit No. 14118

IN NAME OF

Leo E. Paulus

Surveyed Aug. 14, 1943, by Carl Mademan