


T. 2 S., R. 1 W. W.M.

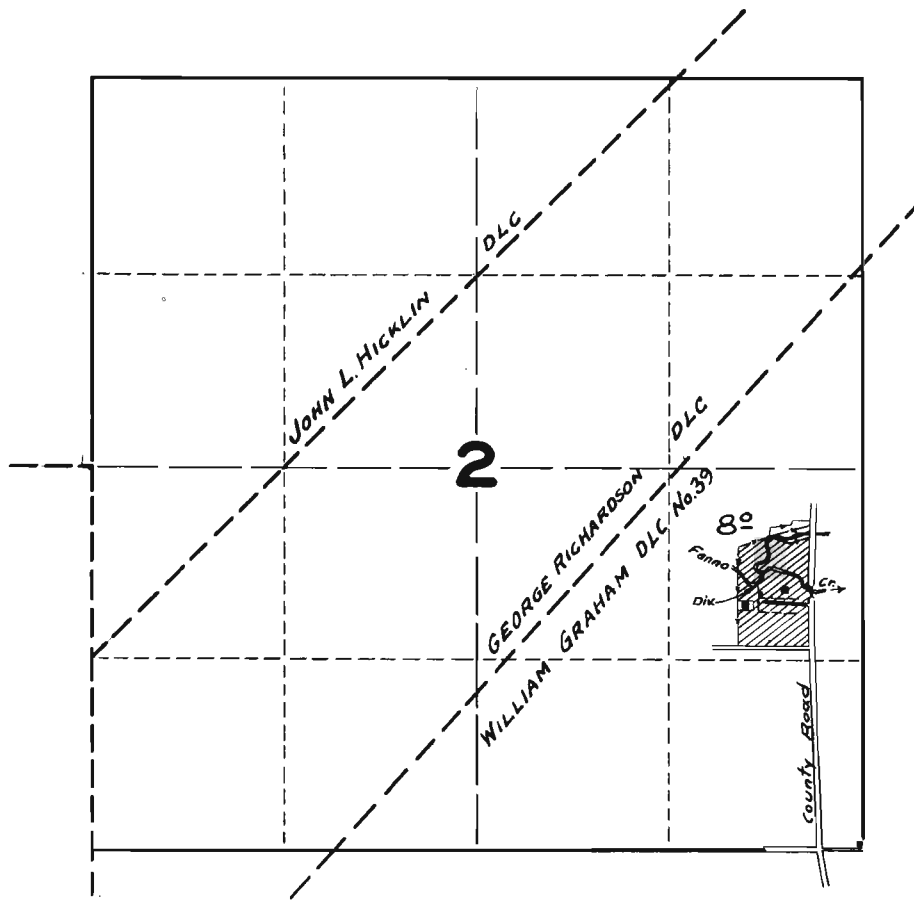

FINAL PROOF SURVEY UNDER

Application No. 18535 Permit No. 14172

IN NAME OF

Surveyed Aug. 3 1942, by Geo. Maderman