


T. 22 S., R. 13 W. W. W.M.

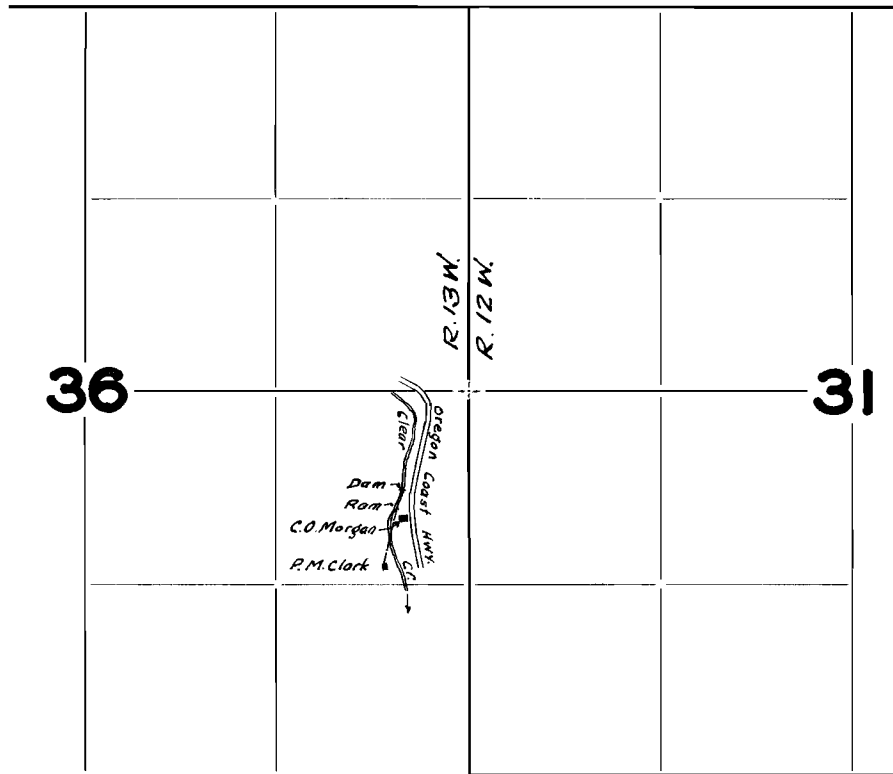

FINAL PROOF SURVEY
UNDER

Application No. 18621 Permit No. 14258

IN NAME OF

P.M. Clark & C.O. Morgan

Surveyed Aug 13 1943, by Geo. Mademan