


T. 29 S., R. 6 W. W.M.

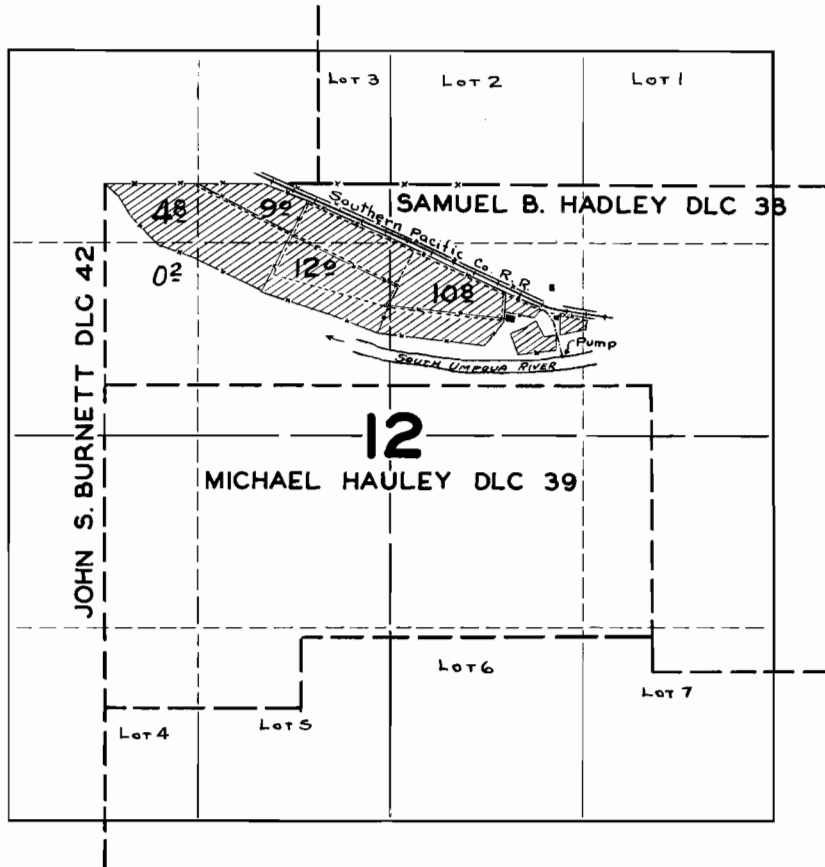

FINAL PROOF SURVEY UNDER

Application No. 18647 Permit No. 14282

IN NAME OF

O. E. Wecks

Surveyed Sept. 7 1943, by Geo. W. Gaderman