


PACIFIC OCEAN

Sand Beach

Toe of Bluff

G. F. Hambright
38.6 A
With easement to Divert Water
as shown below


LOT 3

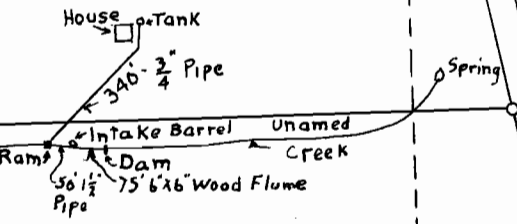

LOT 4

1/4 Cor. 18 17 I.P.

40 Cor. 19 I.P.

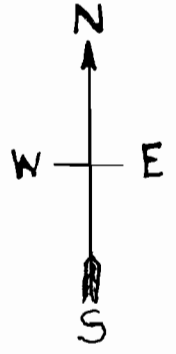

*Application No. 15057
Easement No. 14286*



MAP
SHOWING G.F. HAMBRIGHT
WATER FILEING
CURRY COUNTY, OREGON
Scale 1 in = 400 ft. APRIL, 1940

T385 18 17
R14W 19 20

RECEIVED
APR 9 1940
STATE ENGINEER
S. O. NEWHOUSE