


T. 17 S., R. 8 W. W.M.

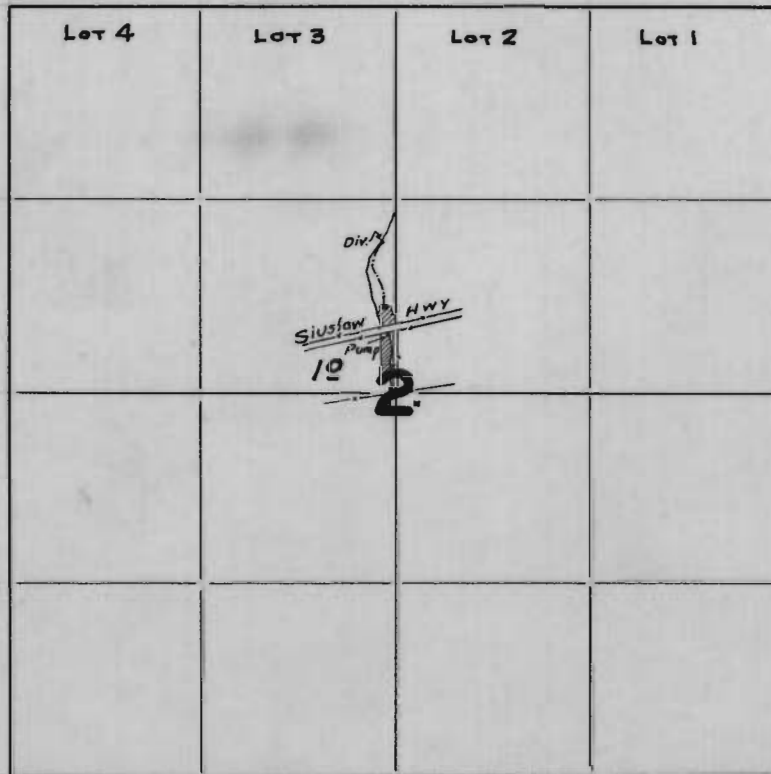

FINAL PROOF SURVEY
UNDER

Application No. 18769 Permit No. 14368

IN NAME OF

Chas. E. Sprague

Surveyed Aug. 9 1943, by Geo. W. Maderman