


T.17 S., R. 4 W.W.M.

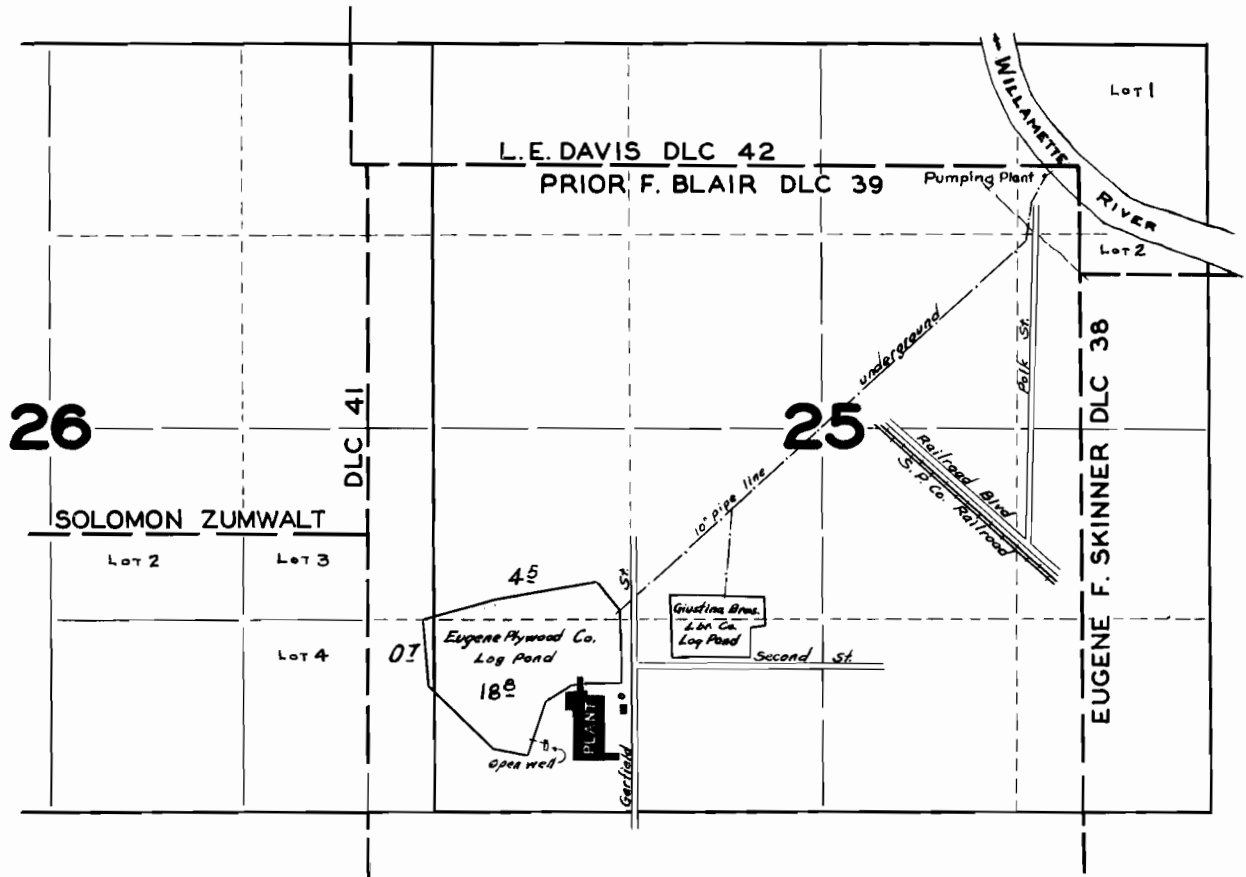

FINAL PROOF SURVEY

UNDER

Application No. 18986 Permit No. 14379

IN NAME OF

Eugene Plywood Company

Surveyed *Sept. 17 1943*, by *Geol. Mederman*