


# T. 7 S., R. 3 W.W.M.

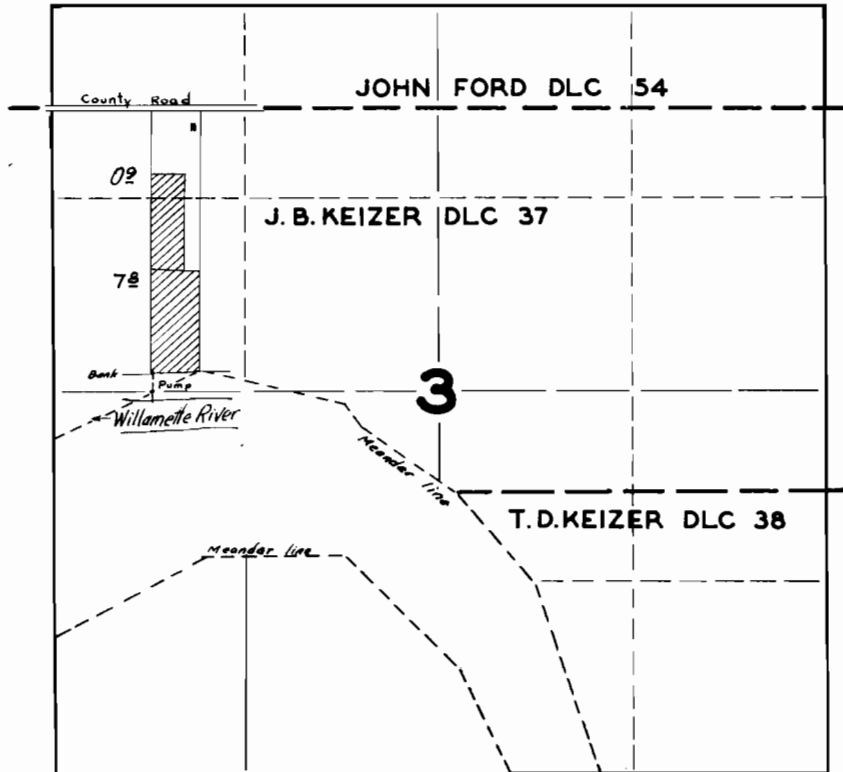

## FINAL PROOF SURVEY

UNDER

Application No. 18806 Permit No. 14446

IN NAME OF

Joseph A. & Marie C. Diedrich

Surveyed Sept 22 1943, by Geo. O. Naderman