


T. 6 S. R. 1 W. W. M.

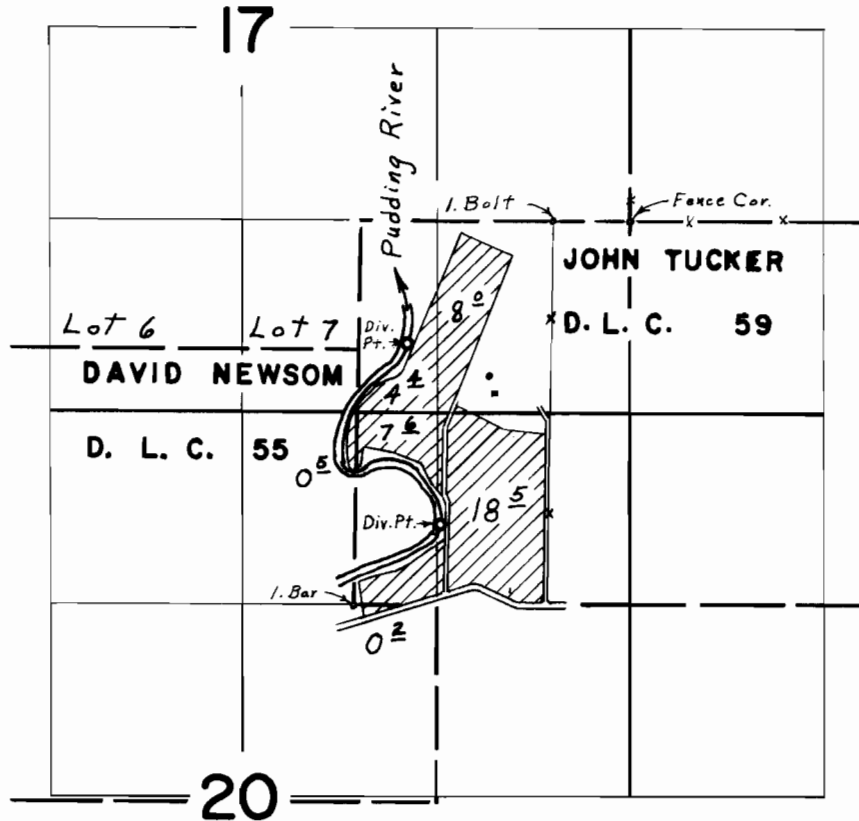

FINAL PROOF SURVEY UNDER

Application No. 18840 Permit No. 14475
IN NAME OF

OLE SATERN

Surveyed July 3, 1942, by Geo. V. Naderman