


T. 20 S., R. 5 W. W.M.

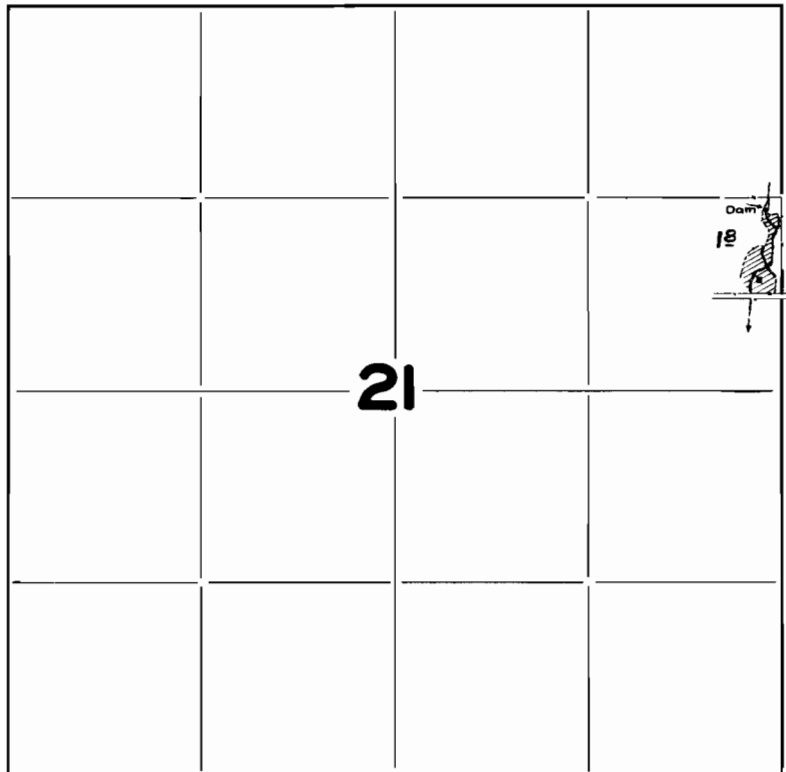

FINAL PROOF SURVEY

UNDER

Application No. 18925 Permit No. 14535

IN NAME OF

Ben I. Craig

Surveyed Sept 15 1943, by Geo. Naderman