


T. 28 S., R. 13 W. W.M.

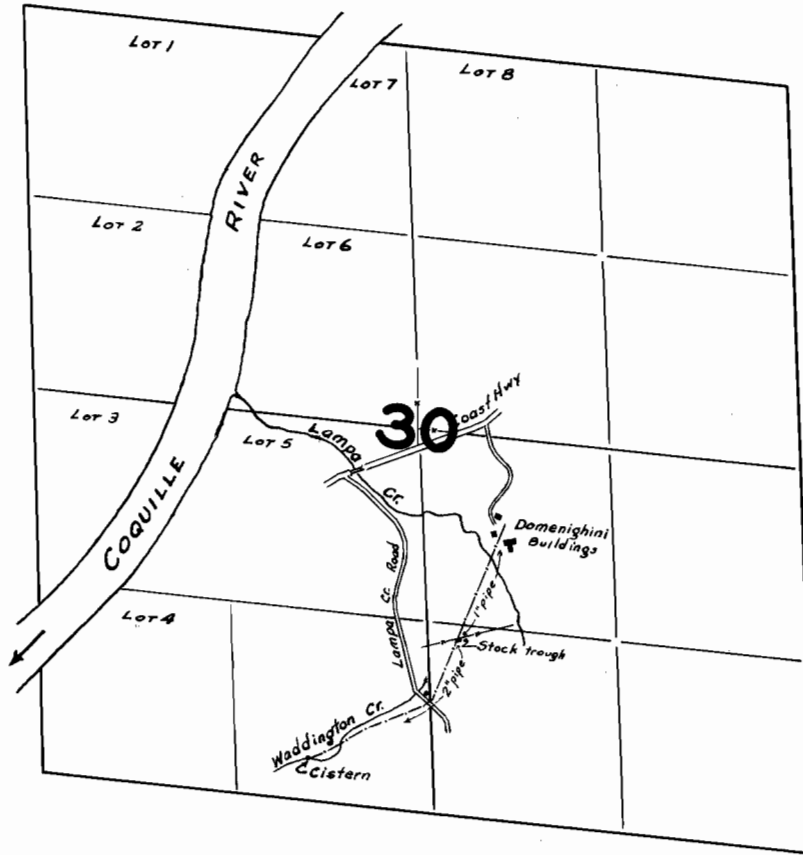

FINAL PROOF SURVEY  
UNDER

Application No. 19043 Permit No. 14578

IN NAME OF

Silvo Domenighini Estate

Surveyed Aug. 31, 1943, by Geo. J. Adelman