


T. 18 S., R. 8 W.W.M.

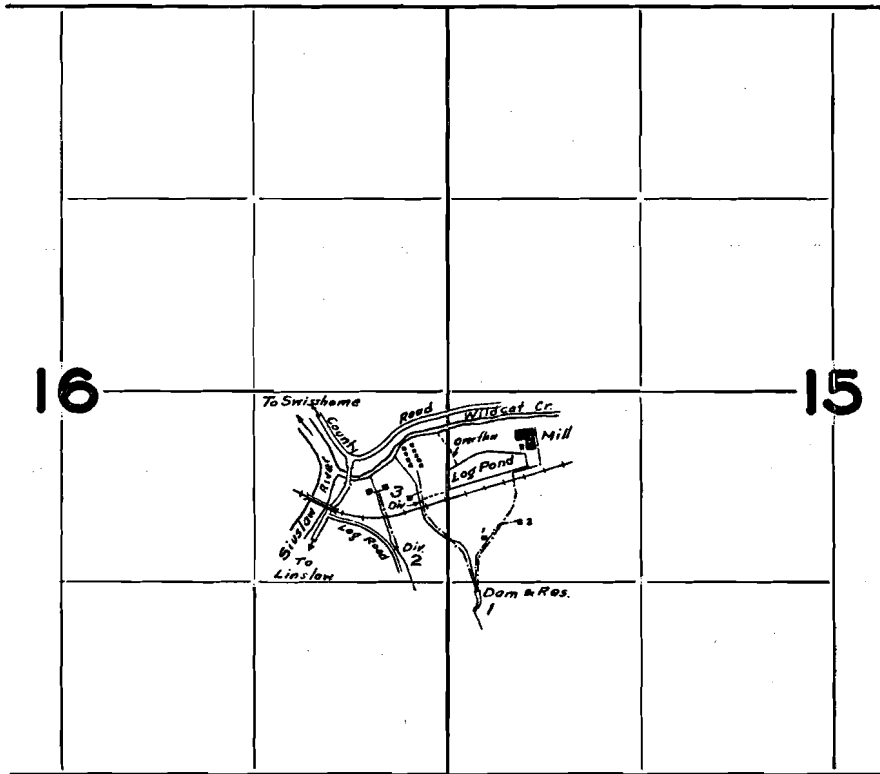

FINAL PROOF SURVEY

UNDER

Application No. <sup>18985</sup> ~~19014~~ Permit No. <sup>14604</sup> ~~R-757~~

IN NAME OF

Austa Lumber Co.

Surveyed Aug. 10, 1943, by Geo. W. Pederman