


# T. 7 S..R. 1 E.W.M.

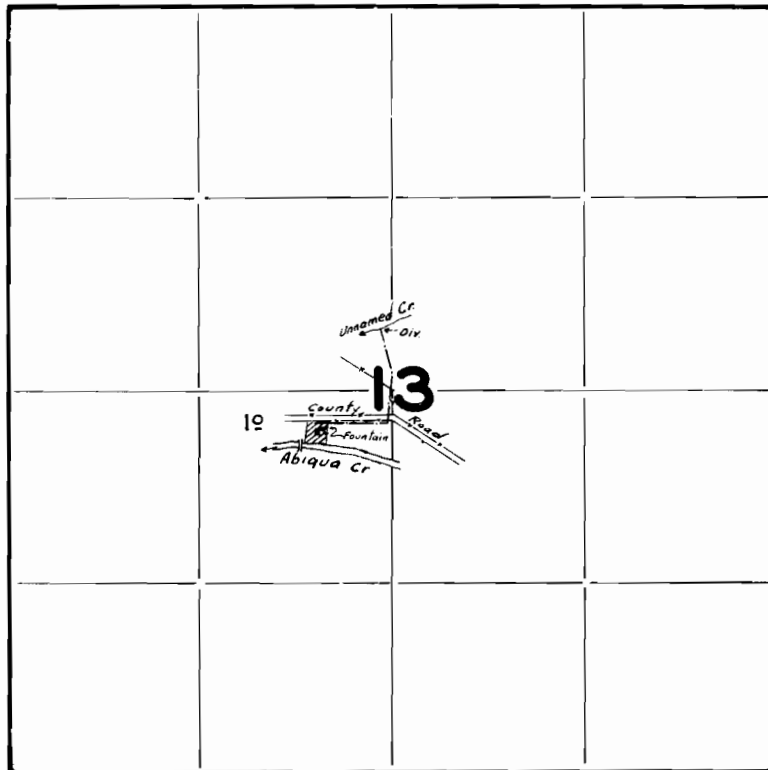

19087

14679

D. E. Harlan

Sept. 20 43. Geo. W. Maderman