


T. 17 S., R. 3 W. W.M.

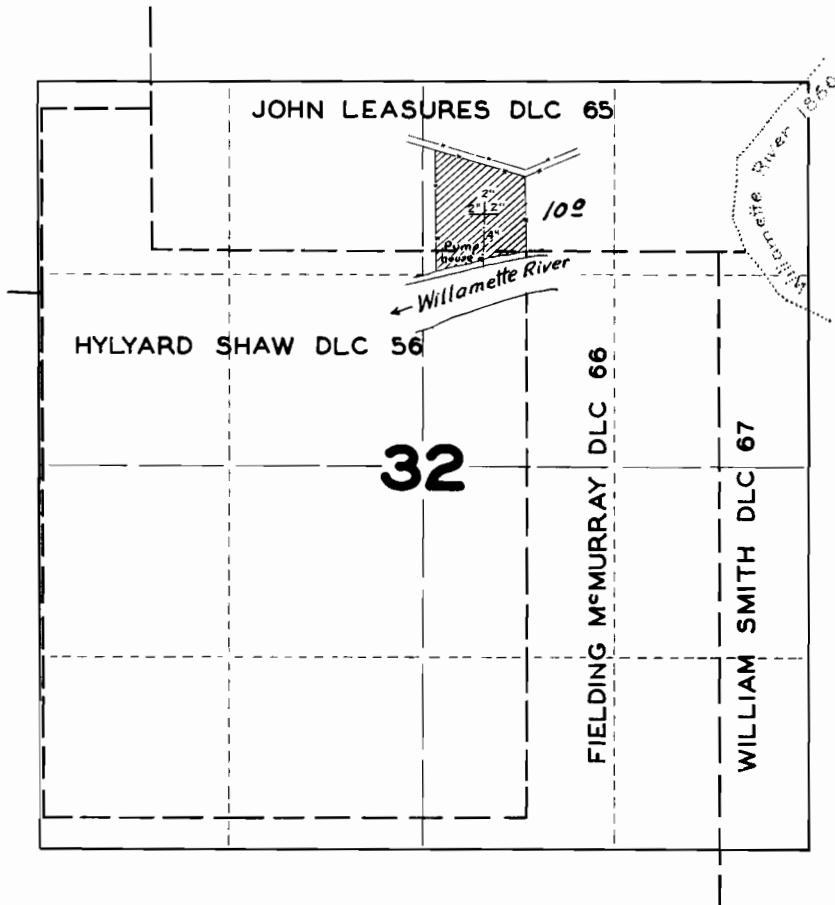

FINAL MAP SURVEY

19173

19173 Permit No. 14770

J. D. Hamlin

Aug. 4, 1943, by Geo. V. Maderman