


T. 26 S., R. 3 W. W.M.

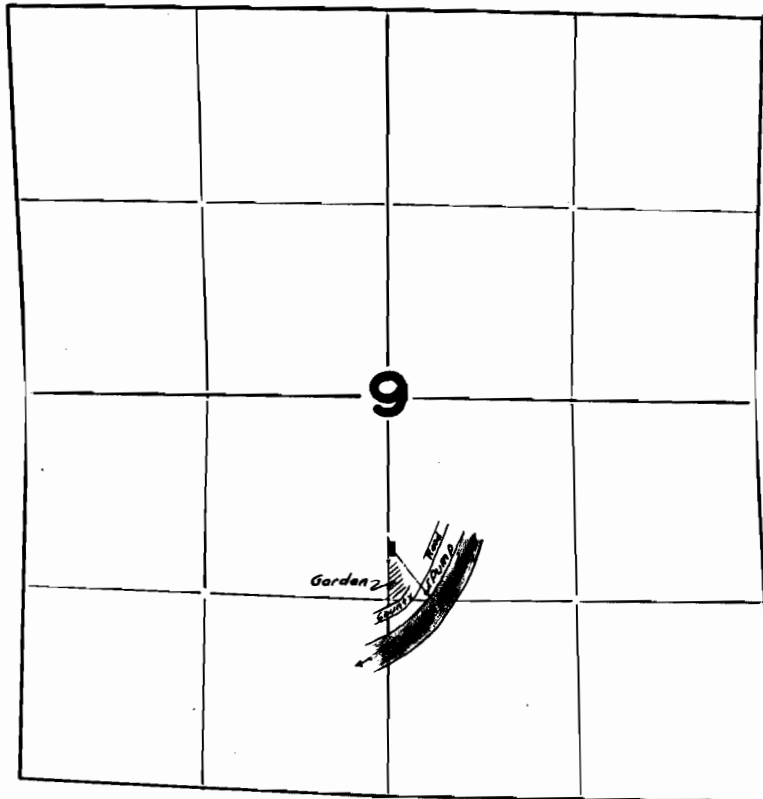

**FINAL PROOF SURVEY**

UNDER

Application No. 19217 Permit No. 14807

IN NAME OF

Ada Lombard Wood

Surveyed Sept. 11, 1943, by Geo. O. Naderman