


# T. 29 S., R. 15 W. W.M.

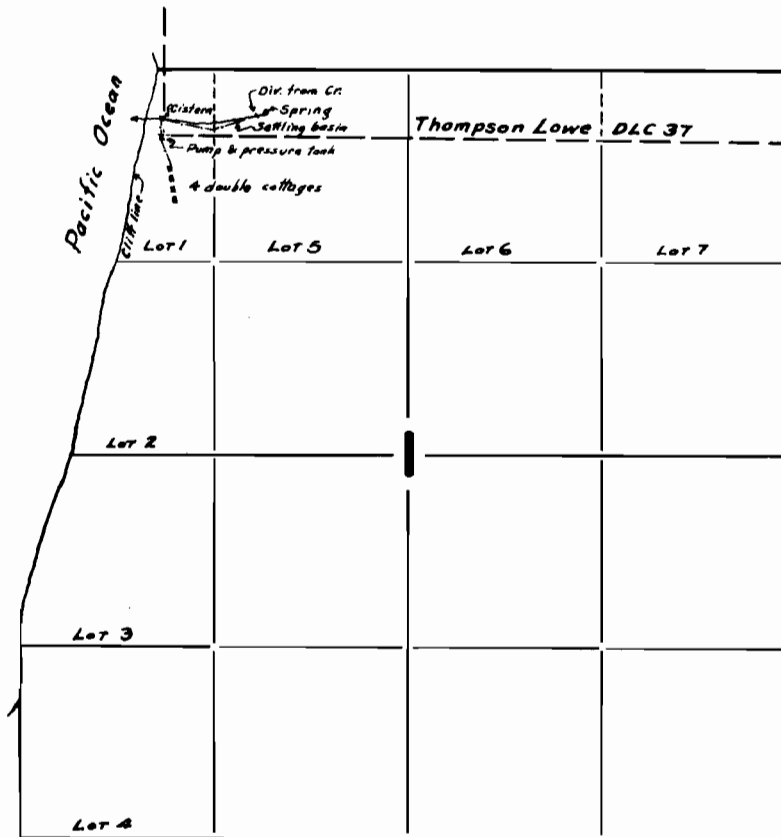

## FINAL PROOF SURVEY

UNDER

Application No. 19211 Permit No. 14846

IN NAME OF

E. Lura Morgan

Surveyed Aug. 31, 1943, by Geoff Naderman