


T. 36 S., R. 15 W. W.M.

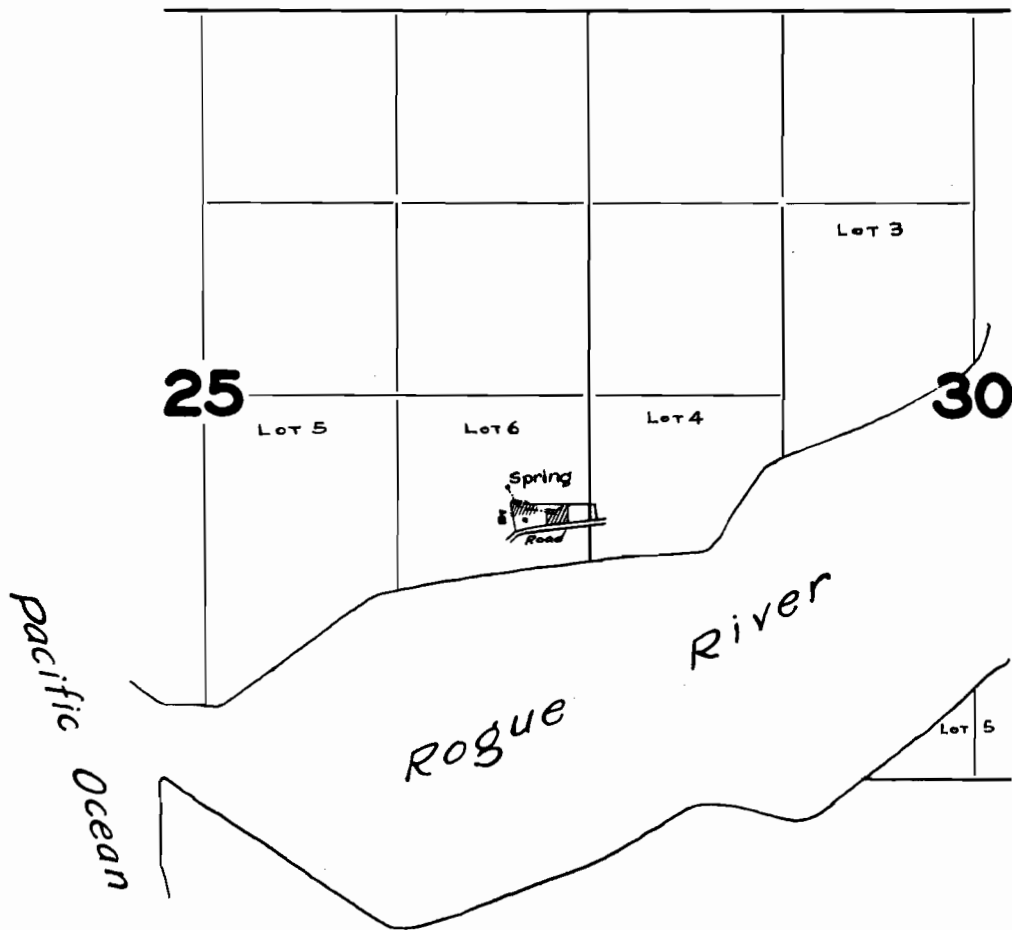

**FINAL PROOF SURVEY
UNDER**

Application No. 19241 Permit No. 14854

IN NAME OF

S. O. Newhouse

Surveyed Sept 2 1943, by Geo W. Mademan