




T. 16 S. R. 1 W. W.M.

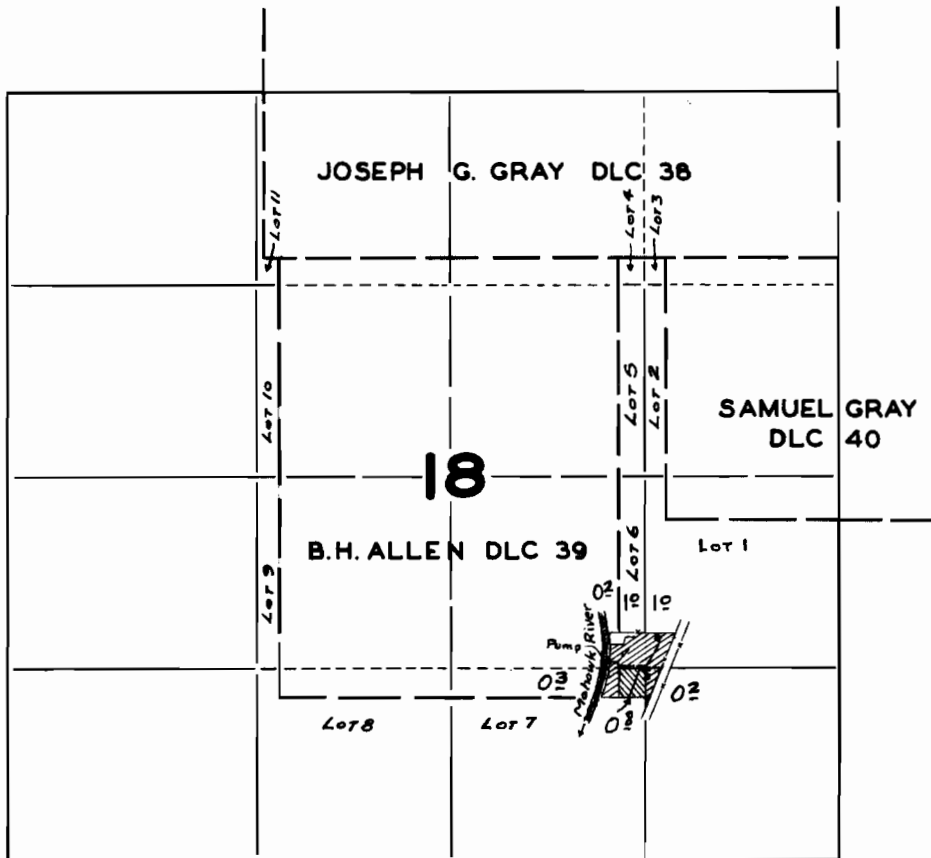

-  Permit 13534
-  Permit 14863

FINAL PROOF SURVEY

UNDER

Application No. ¹⁷⁸⁴⁹~~19265~~ Permit No. ¹³⁵³⁴~~14863~~

IN NAME OF

Ray A. & Marguerite M. Winegar

Surveyed *Aug. 3* 1943, by *Geo. Daderman*