


T. 7 S., R. 3 W. W.M.

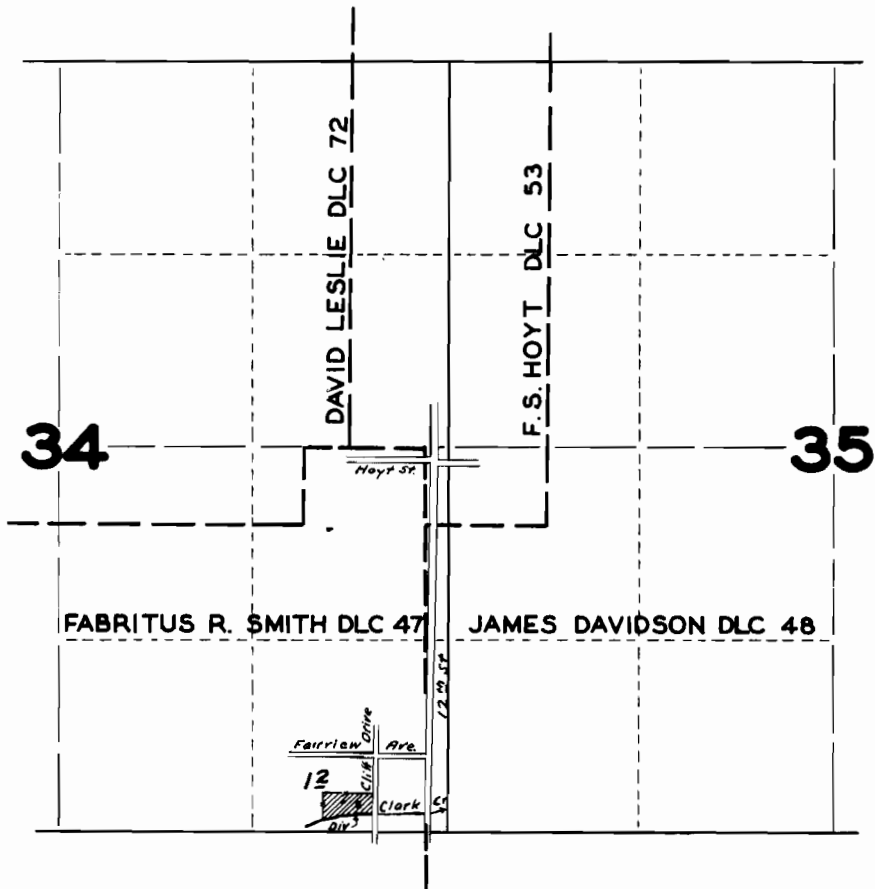

FINAL PROOF SURVEY
UNDER

Application No. 19301 Permit No. 14887

IN NAME OF

Reed G. White

Surveyed July 26 1943, by Geol. Underman