


T. 25 S., R. 4 W. W.M.

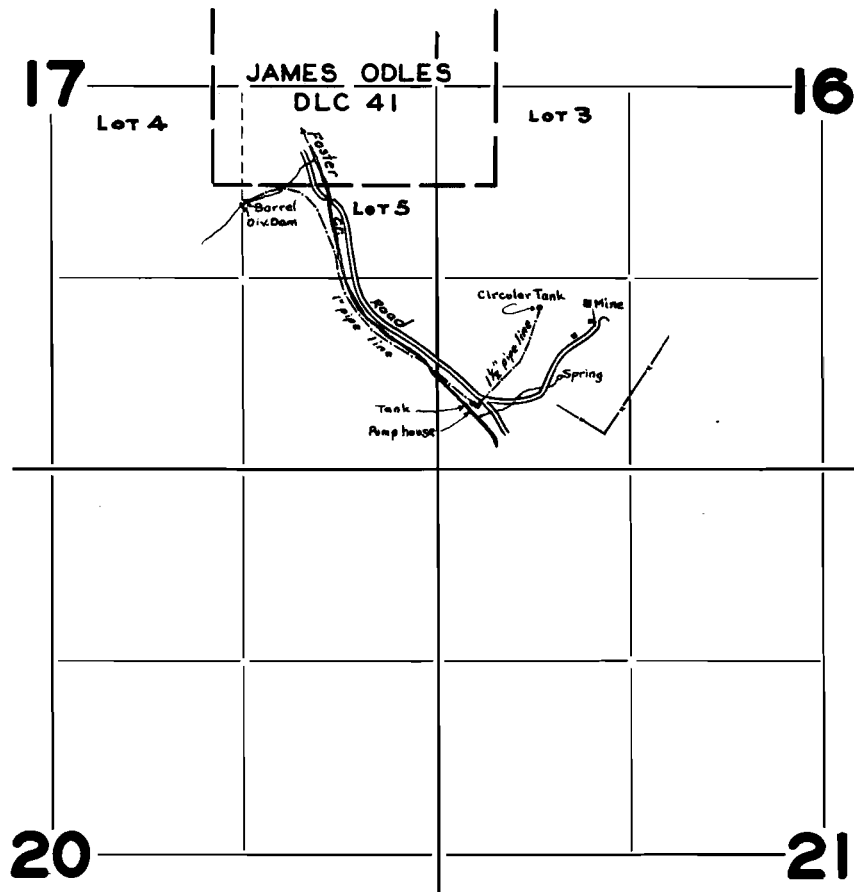

FINAL PROOF SURVEY

UNDER

Application No. 19329 Permit No. 14922

IN NAME OF

Bonanza Mines, Inc.

Surveyed Sept. 13 1943, by E. O. Adersma